
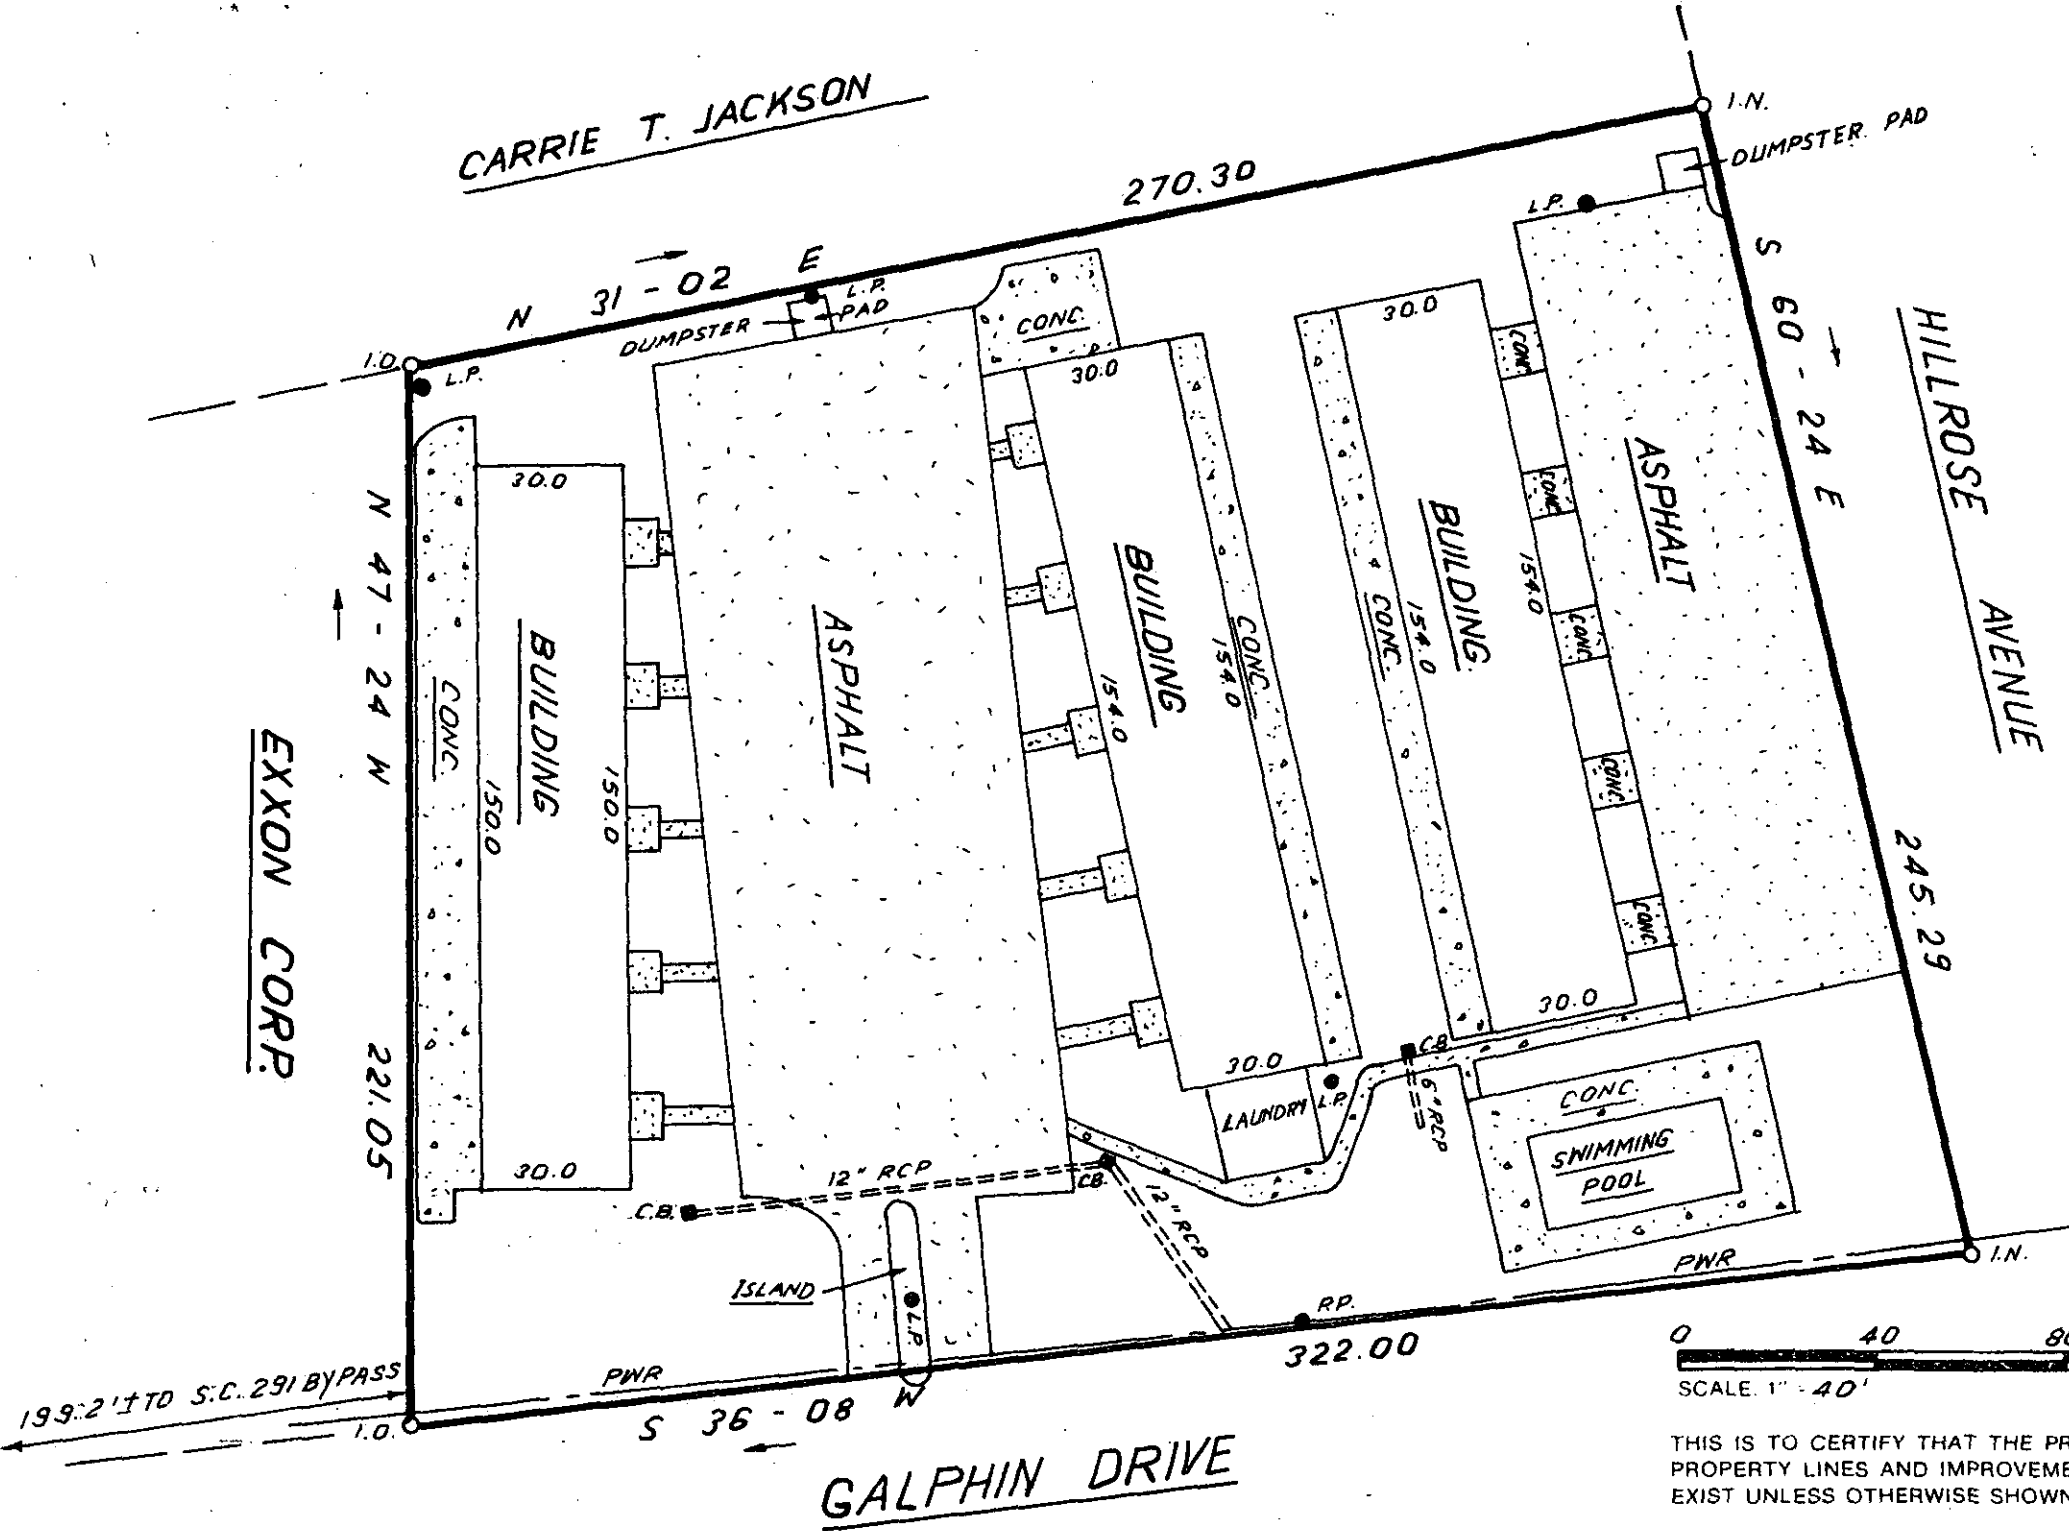


FILED
 GREENVILLE CO. S.C.
 MAR 30 12 27 PM '84
 DONNIE S. TANKERSLEY
 R.M.C.

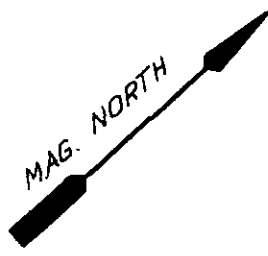


MAR 30 1984

30324

10-I-76



THIS IS TO CERTIFY THAT THE PROPERTY SHOWN ON THIS PLAT WAS SURVEYED UNDER MY DIRECT SUPERVISION. PROPERTY LINES AND IMPROVEMENTS SHOWN ARE LOCATED CORRECTLY AND THAT NO VISIBLE ENCROACHMENTS EXIST UNLESS OTHERWISE SHOWN. THIS PROPERTY IS NOT LOCATED IN A DESIGNATED FLOOD HAZARD AREA.

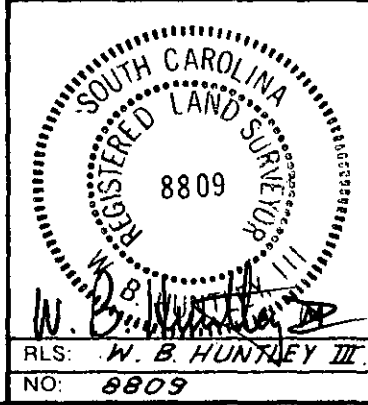

STATE OF SOUTH CAROLINA
 GREENVILLE COUNTY

FREDRICKSBURG APTS.
SURVEY FOR
DONALD F. WAGGONER

FREELAND & ASSOCIATES
 Engineers • Land Surveyors
 318 WEST STONE AVENUE,
 GREENVILLE, S.C.
 (803) 271-4924

PLAT BOOK	AAA - 83
DEED BOOK	1095 - 181
TAX MAP	P11 - 5 - 7
PARTY CHIEF	D. G.
DRAWN	B. R.
DATE	3 - 19 - 84
DWG. NO.	10733 5.000D

RLS: W. B. HUNTLEY III.
 NO: 8809