


MICROFILMED

FILED
GREENVILLE CO. S.C.

9.33
DONNIE S. TANKERSLEY
R.M.C.

TRACT "N"

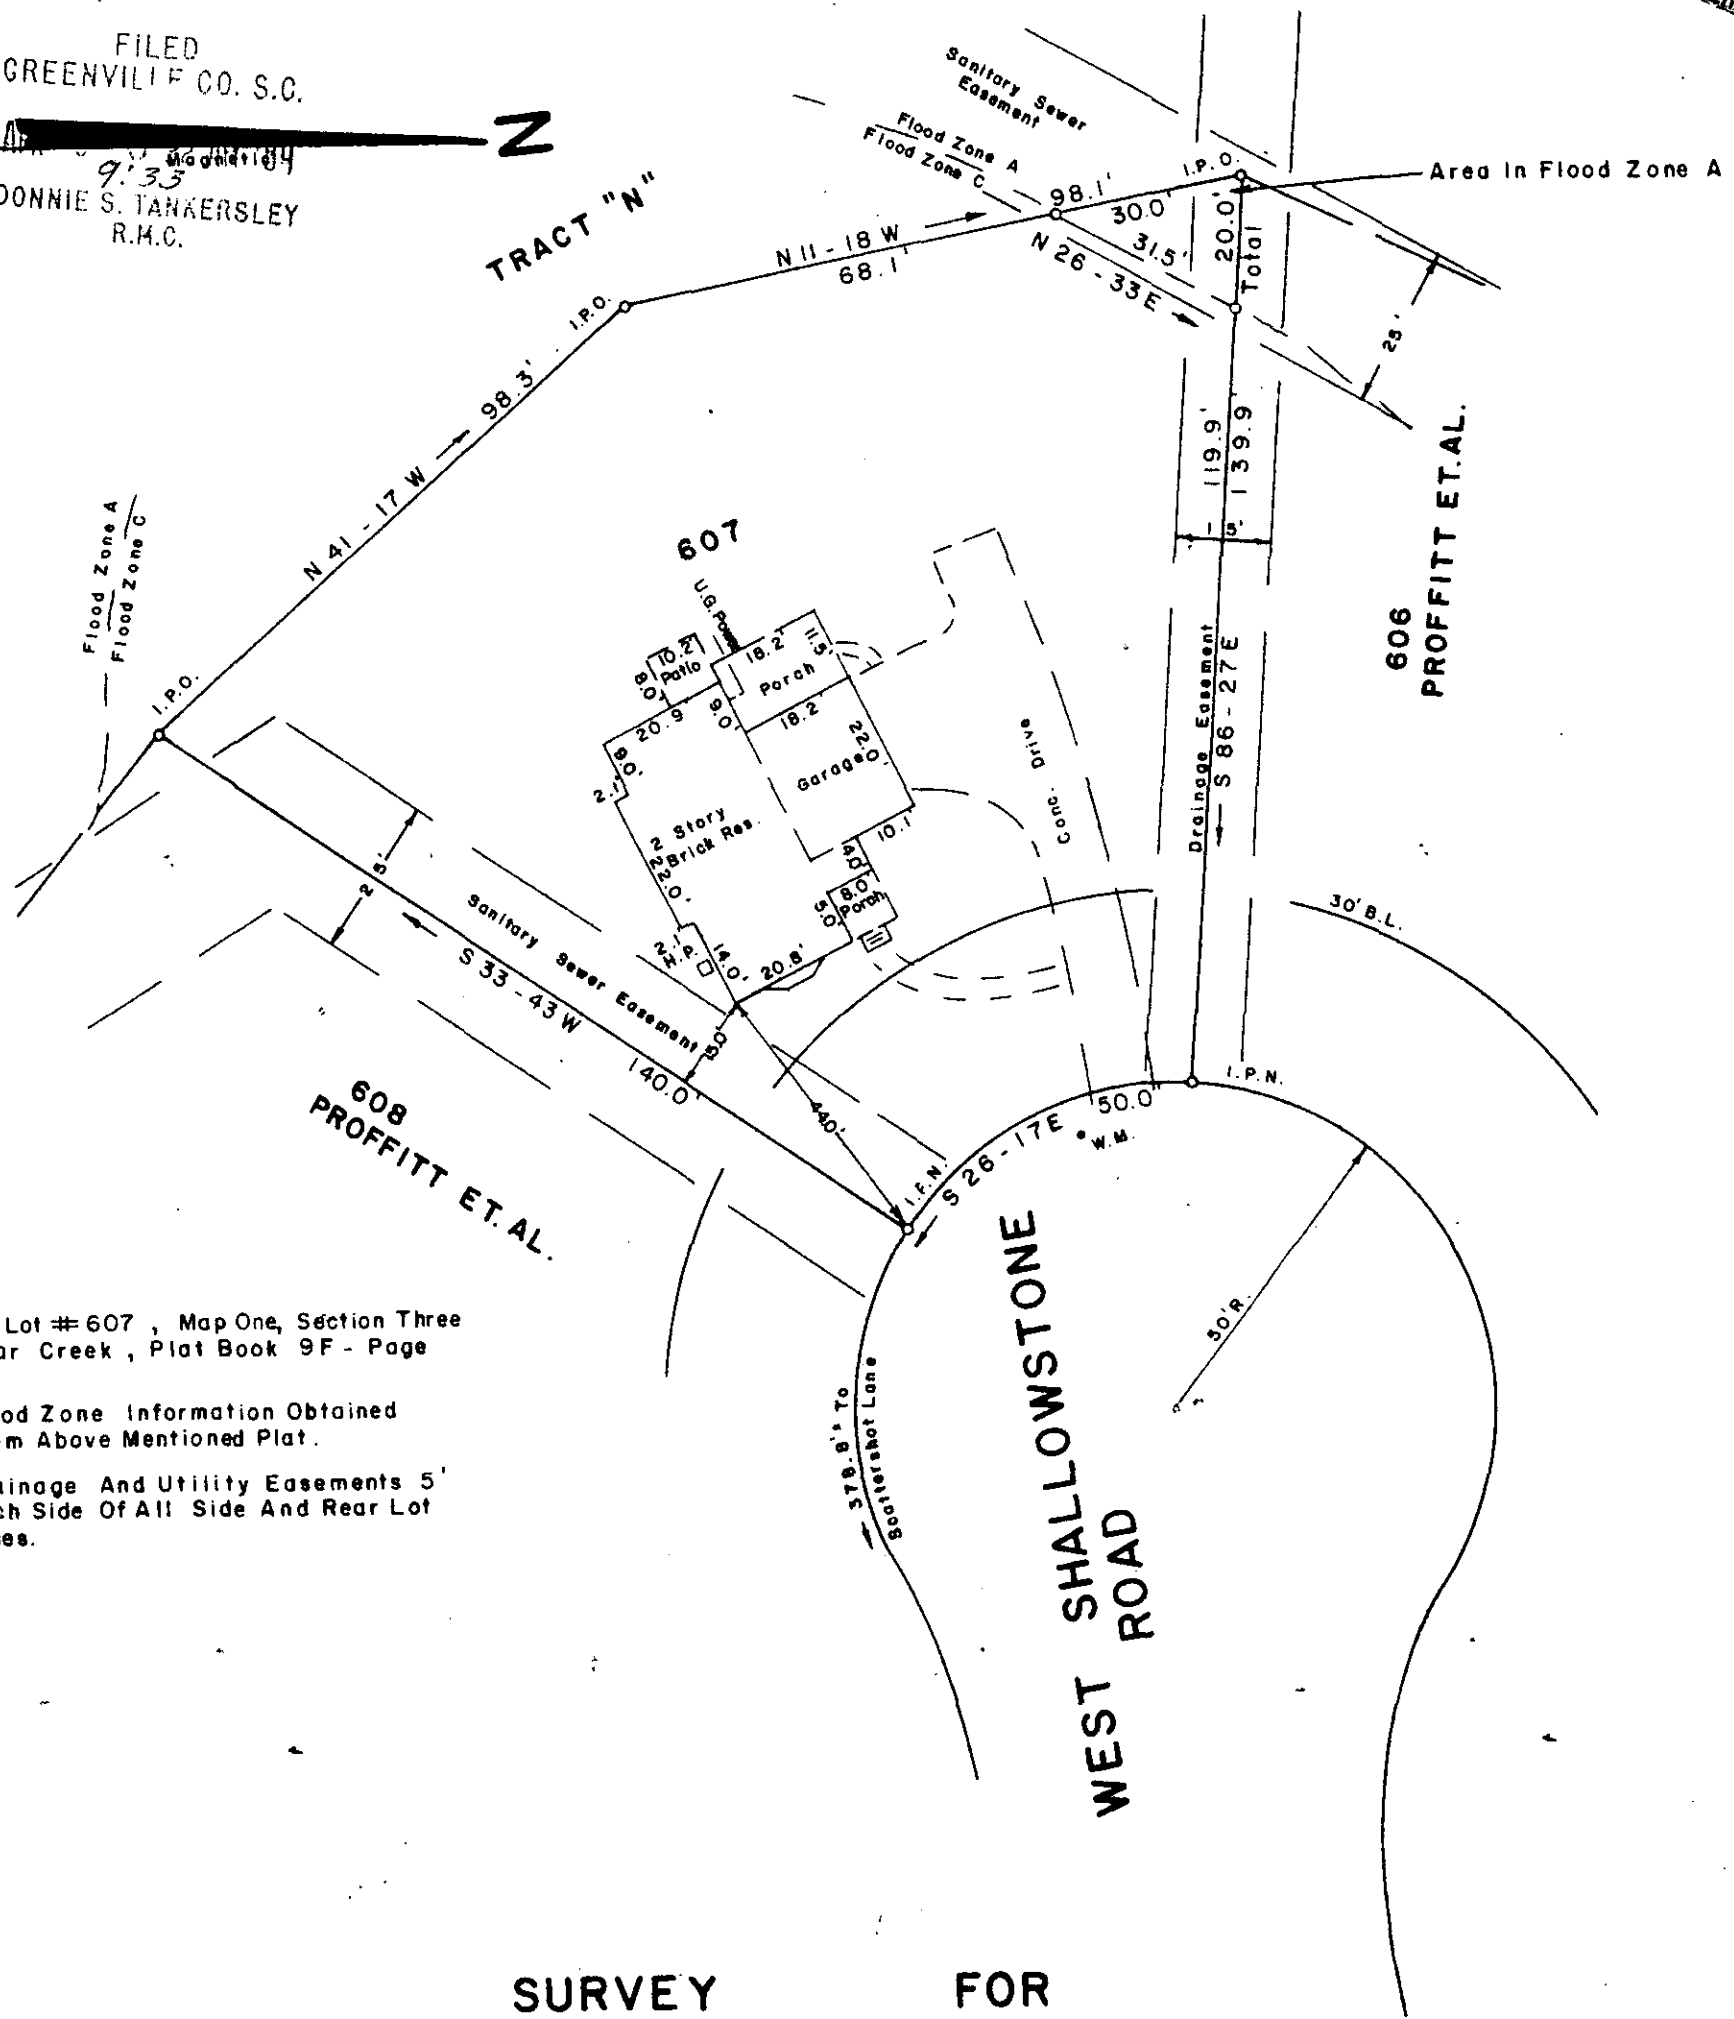

Note:
 This Lot # 607, Map One, Section Three
 Sugar Creek, Plat Book 9F - Page
 35.
 * Flood Zone Information Obtained
 From Above Mentioned Plat.
 Drainage And Utility Easements 5'
 Each Side Of All Side And Rear Lot
 Lines.

SURVEY FOR
JOHN J. WARNER
JACQUELYN C. WARNER
 NEAR GREENVILLE SOUTH CAROLINA
 MARCH 26, 1984

10-I-81


To The Best Of My Knowledge This Structure
Is In Flood Zone C

I Herby Certify That The Measurements As
Shown Above Are Correct And There Are No
Encroachments Or Projections Other Than
Shown.

I Herby Certify That The Ratio Of Precision
Of The Field Survey Is 1/5000 As
Shown Hereon And The Area Was Determined
By D.M.O. Method.

JEFFERY M. PLUMBLEE, INC.
LAND SURVEYING

Jeffery M. Plumblee
 REGISTERED
 SURVEYOR
 P.L.S. # 7881

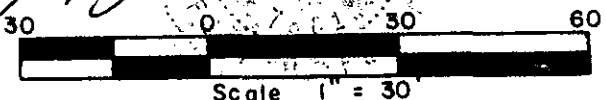

P.O. BOX 788
 TRAVELERS REST. S. C. 29690
 (803) 634-4426

534.10-1-26

F.B. 19