


Note:
This is Lot # 46 Sunny Acres,
Plot Book BB - Page 168, 169.

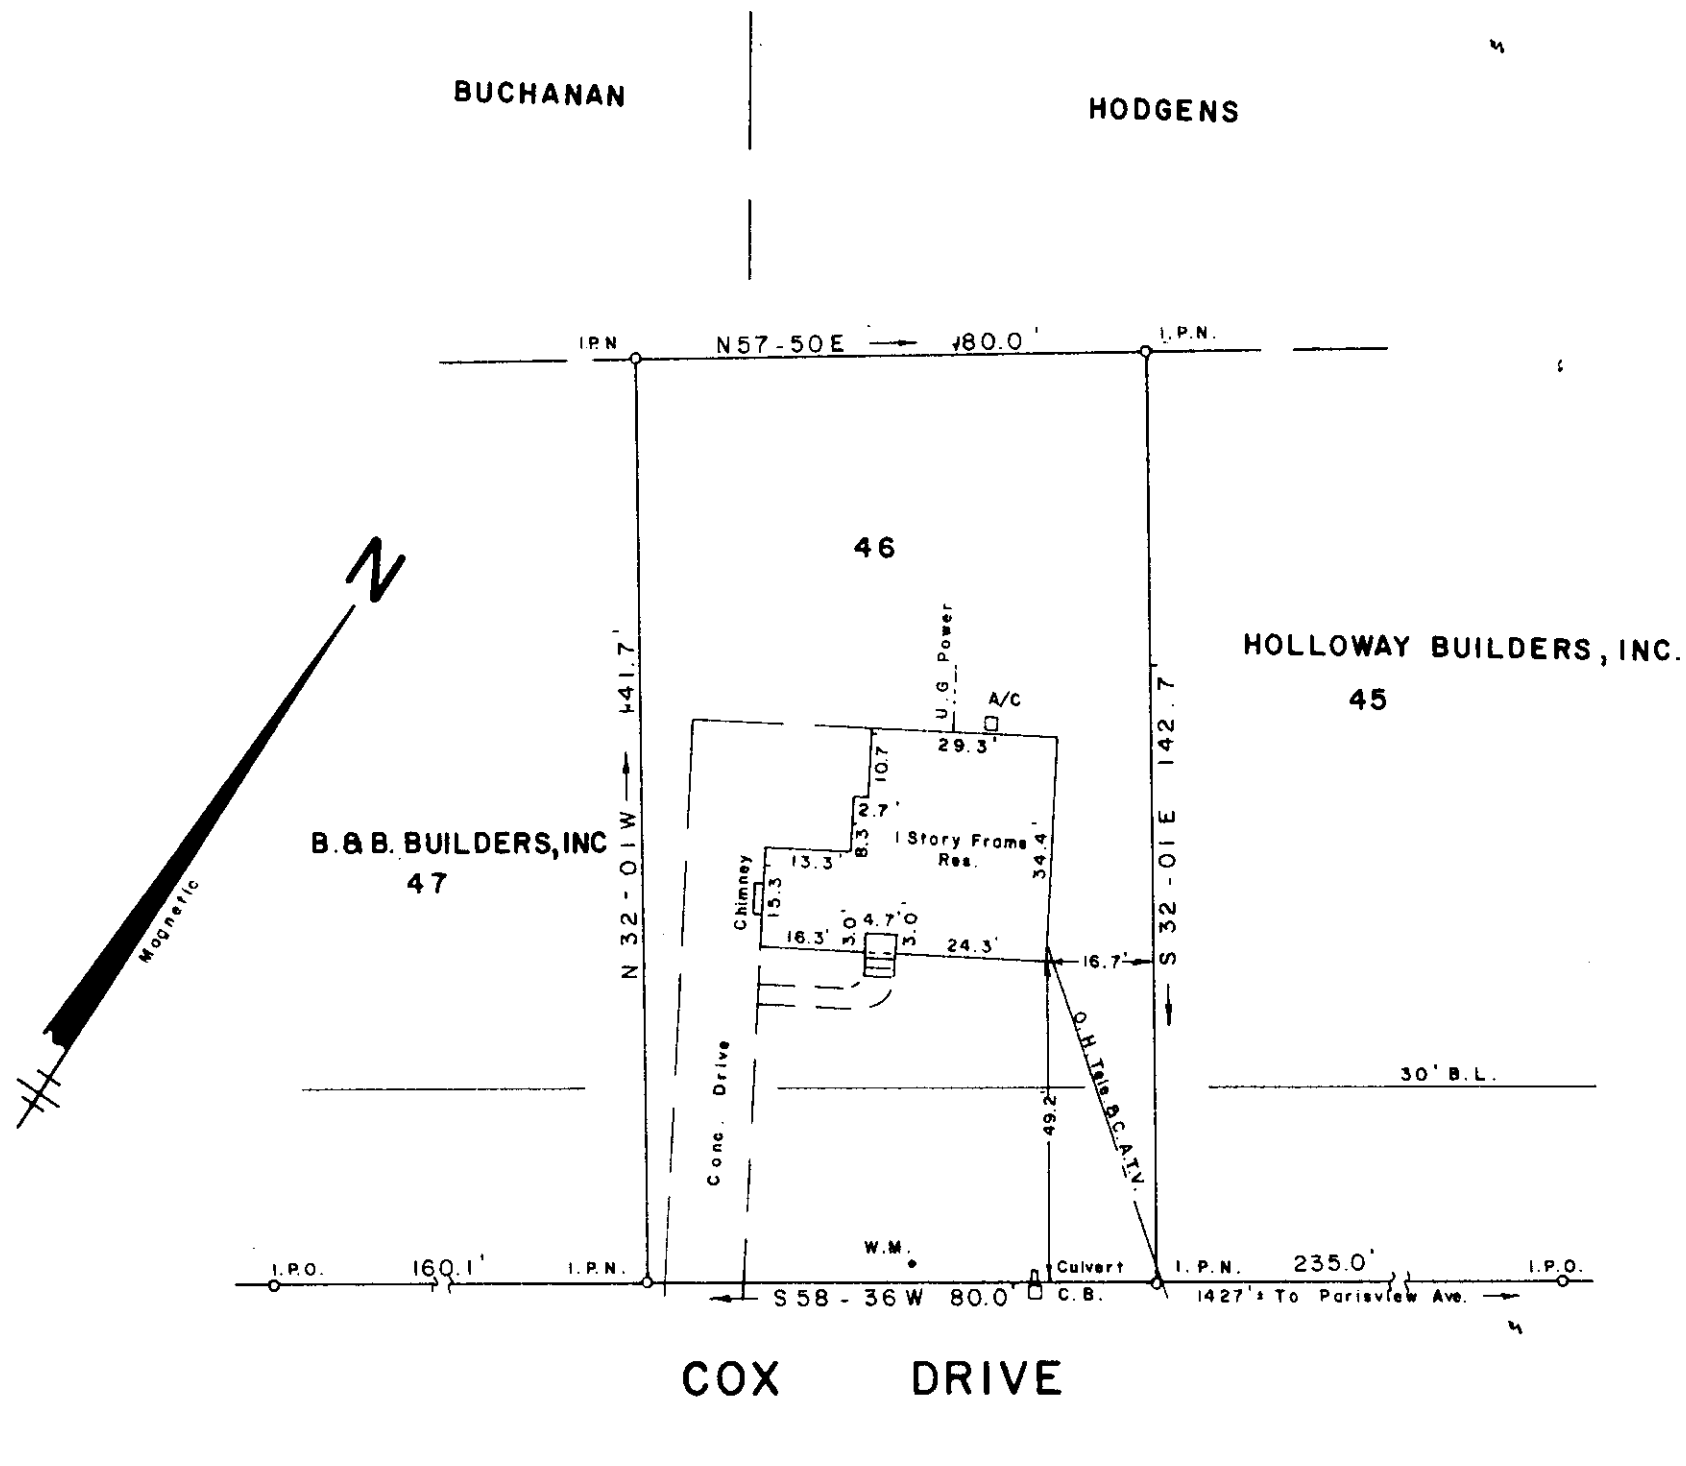

SURVEY FOR
DONALD H. MESSER
VICKIE K. MESSER

CITY OF TRAVELERS REST GREENVILLE CO.
 SOUTH CAROLINA
 MARCH 26, 1984

FILED
 GREENVILLE CO. S.C.
 APR 4 4 11 PM '84
 DONNIE S. TANKERSLEY
 R.H.C.

APR 4 1984

10-I-85

To The Best Of My Knowledge This Structure
Is Not In An Established Flood Zone

30958

I Herby Certify That The Measurements As
Shown Above Are Correct And There Are No
Encroachments Or Projections Other Than
Shown.

I Herby Certify That The Ratio Of Precision
Of The Field Survey Is 1/5000 As
Shown Hereon And The Area Was Determined
By D.M.

JEFFERY M. PLUMBLEE, INC.
LAND SURVEYING

P O BOX 788
TRAVELERS REST, S.C. 29690 (803) 834-4426

Jeffery M. Plumblee
 JEFFERY M. PLUMBLEE
 SURVEYOR S.C. # 7881

