MICROFILMED

FILED
GREENVILLE CO. S.C.
APR 10 3 23 PM '84
DONNIE S. TANKERSLEY
R.M.C.

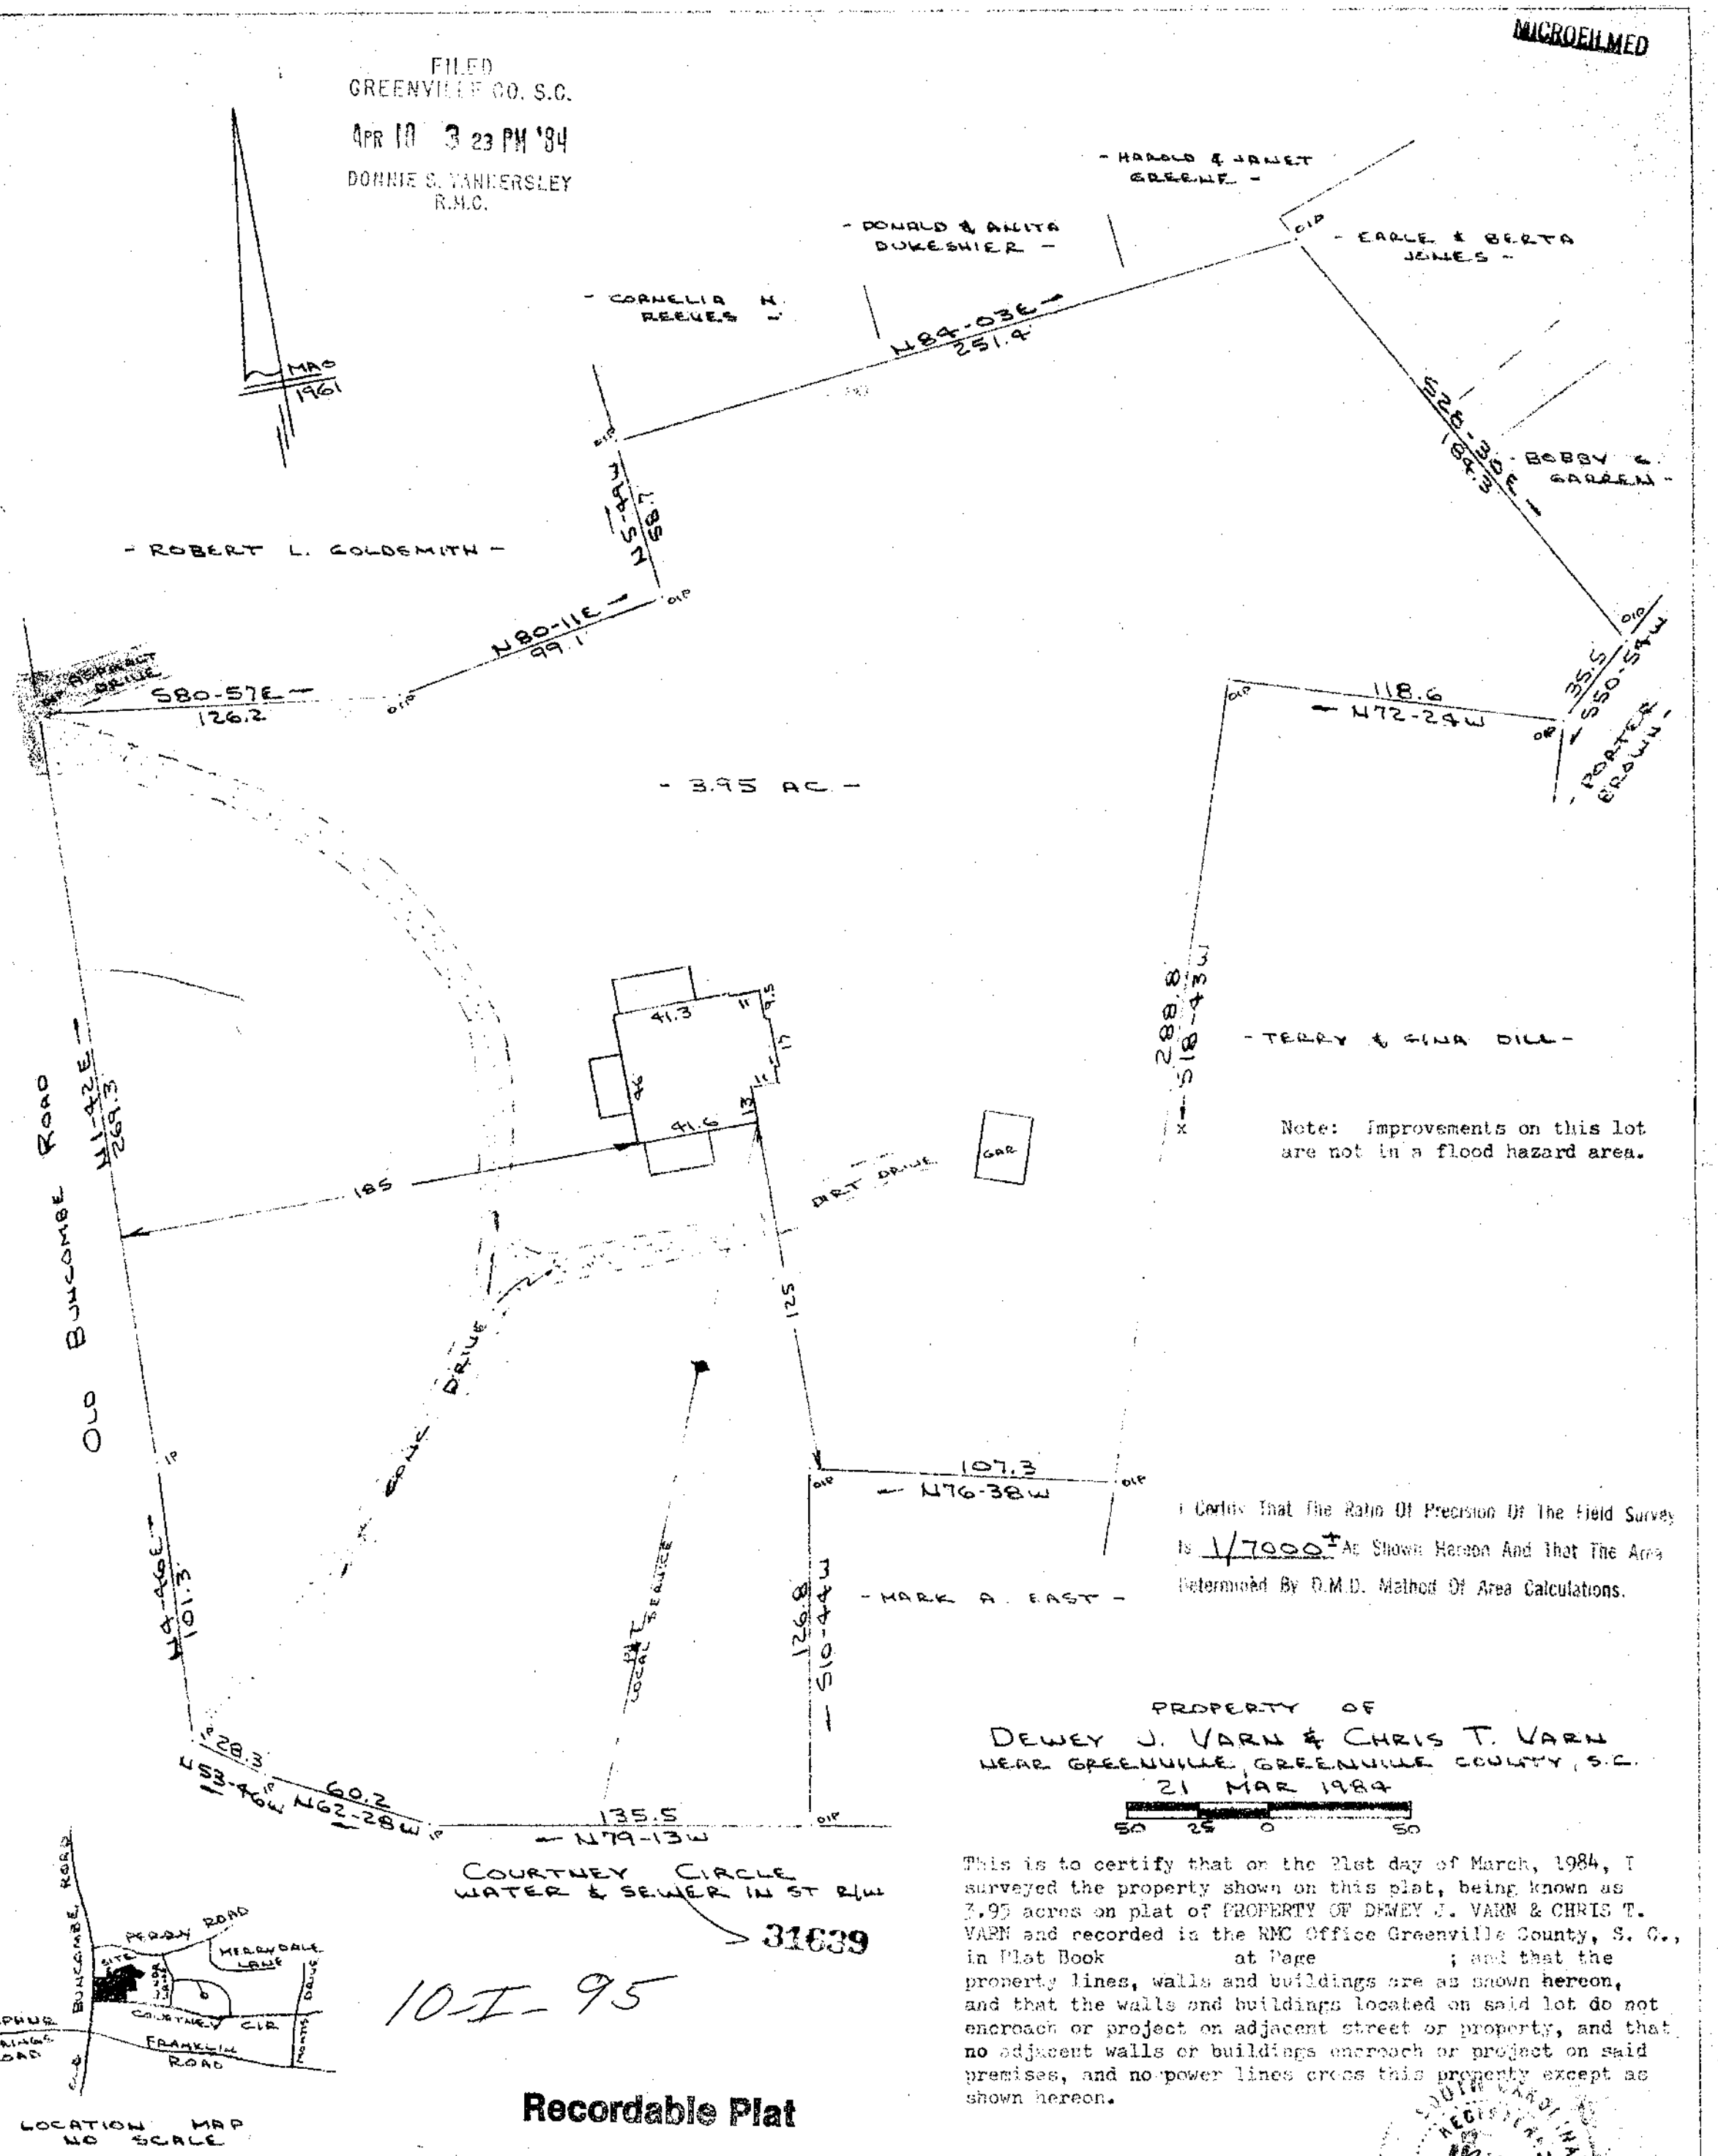

Note: Improvements on this lot are not in a flood hazard area.

I Certify That The Ratio Of Precision Of The Field Survey Is 1/7000± As Shown Hereon And That The Area Determined By D.M.D. Method Of Area Calculations.

PROPERTY OF
DEWEY J. VARN & CHRIS T. VARN
NEAR GREENVILLE, GREENVILLE COUNTY, S.C.
21 MAR 1984

This is to certify that on the 21st day of March, 1984, I surveyed the property shown on this plat, being known as 3.95 acres on plat of PROPERTY OF DEWEY J. VARN & CHRIS T. VARN and recorded in the RMC Office Greenville County, S. C., in Plat Book at Page ; and that the property lines, walls and buildings are as shown hereon, and that the walls and buildings located on said lot do not encroach or project on adjacent street or property, and that no adjacent walls or buildings encroach or project on said premises, and no power lines cross this property except as shown hereon.

Recordable Plat

CAROLINA SURVEYING CO
112 MANLY ST.
GREENVILLE, S.C.

R. B. Farmer
RLS

264/66-68 437-1-2 GCTO -----3 AP 10 84 092 $5.00CD