


FIXED
GREENVILLE
FEB 28 3 51 PM '84
DONNIE S. TANKERSLEY
R.M.C.

Note: Residence on this lot is not in a flood hazard area.

PROPERTY OF
JAMES B. SPEARS, JR.
NEAR GREENVILLE, S.C.
23 FEB 1984

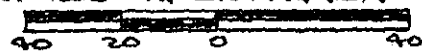

This is to certify that on the 23rd day of February, 1984, I surveyed the property shown on this plat, being known as 1.07 acres or plat of PROPERTY OF WILLIAM L. COSTNER and recorded in the REC Office Greenville County, S.C., in Plat Book "TT" at Page 47; and that the property lines, walls and buildings are as shown hereon, and that the walls and buildings located on said lot do not encroach or project on adjacent street or property, and that no adjacent walls or buildings encroach or project on said premises, and no power lines cross this property except as shown hereon.

26656

✓10J-18

FEB 29 1984
R. B. Brice
R. B. Brice, R.S. 1952
R. B. Brice

CAROLINA SURVEYING CO.
112 OTO Manly St.
Greenville, S. C. 29604

088 3.0000