MICROFILMED

FILED
GREENVILLE C
MAR 1 3 37 PM
DONNIE S. TANKERS
R.M.C.

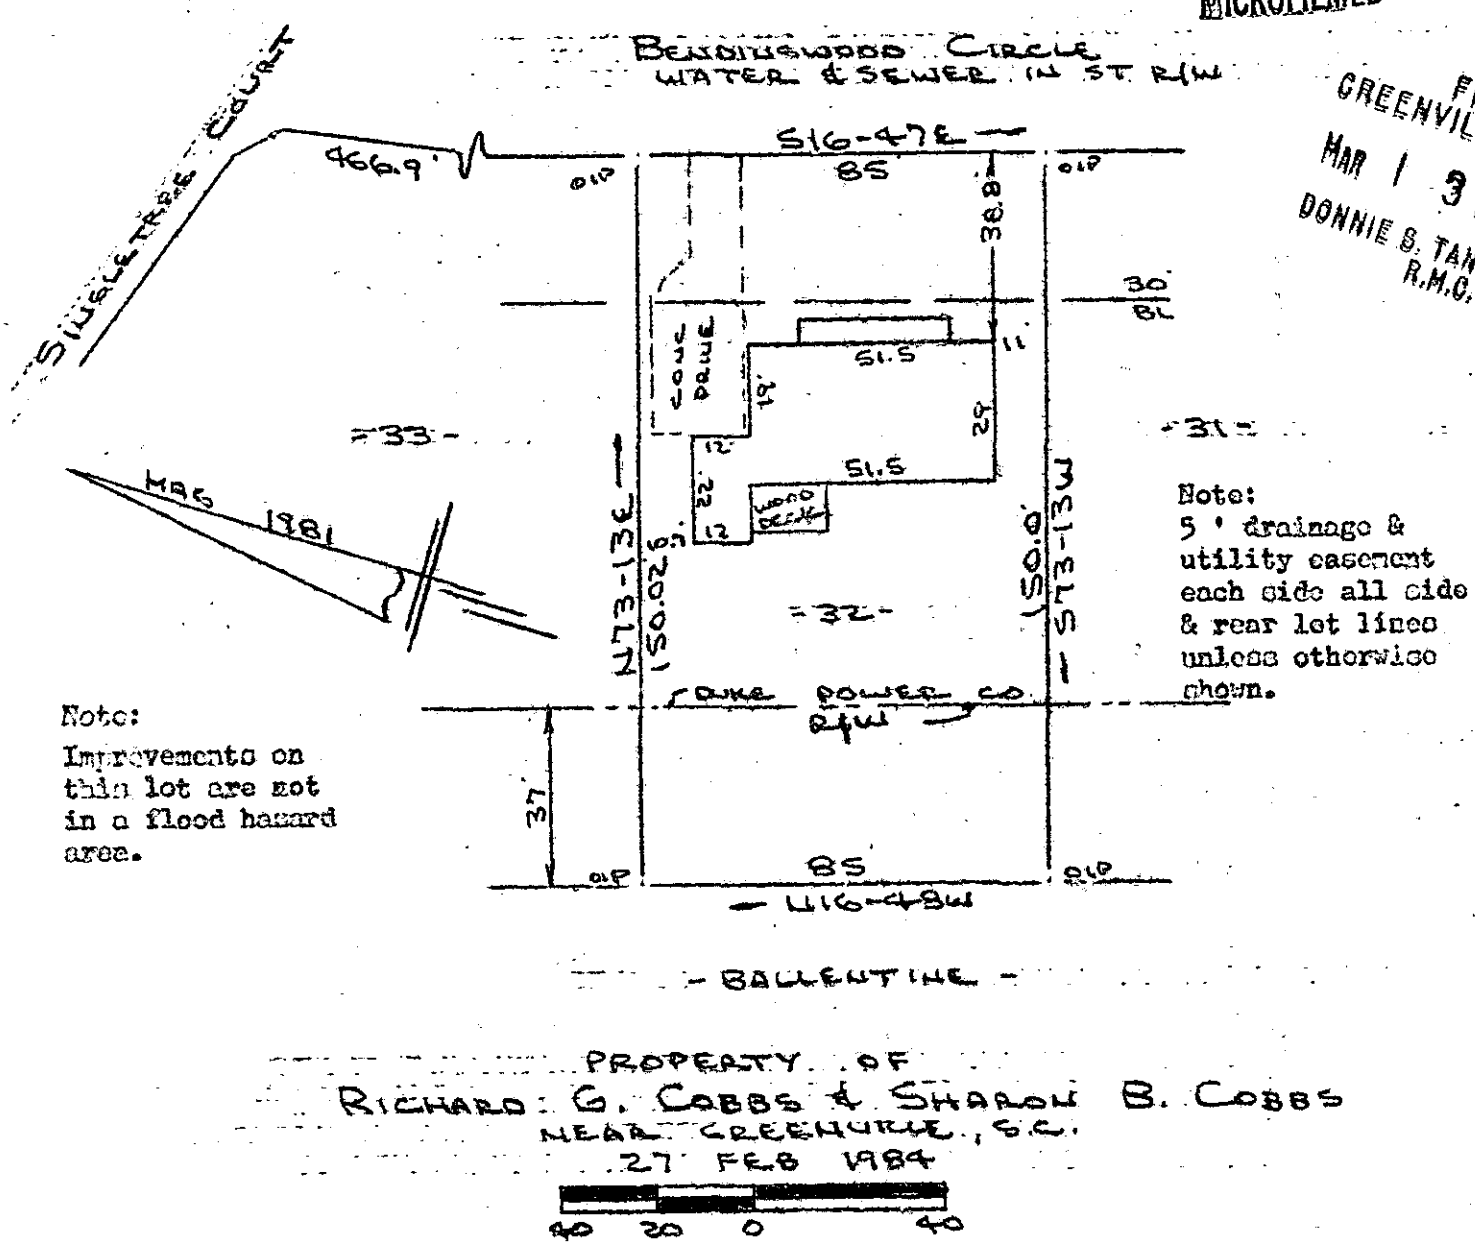


This is to certify that on the 27th day of February, 1984, I surveyed the property shown on this plat, being known as lot 32 on plat of NORTHWOOD SECTION 1 and recorded in the RMC Office Greenville County, S. C., in Plat Book " 7 - X " at Pg. 98; and that the property lines, walls and buildings are as shown hereon, and that the walls and buildings located on said lot do not encroach or project on adjacent street or property, and that no adjacent walls or buildings encroach or project on said premises, and no power lines cross this property except as shown hereon.

26807 ✓

**Recordable Plat**

MAR 1 1984

R. B. Bruce

R. B. Bruce, RLS #1952

10-J-31

CAROLINA SURVEYING CO.
112 Manly St.
Greenville, S. C.

3.00CI

970

2 MR 1 84

265/47

541.6-1-2