MICROFILMED

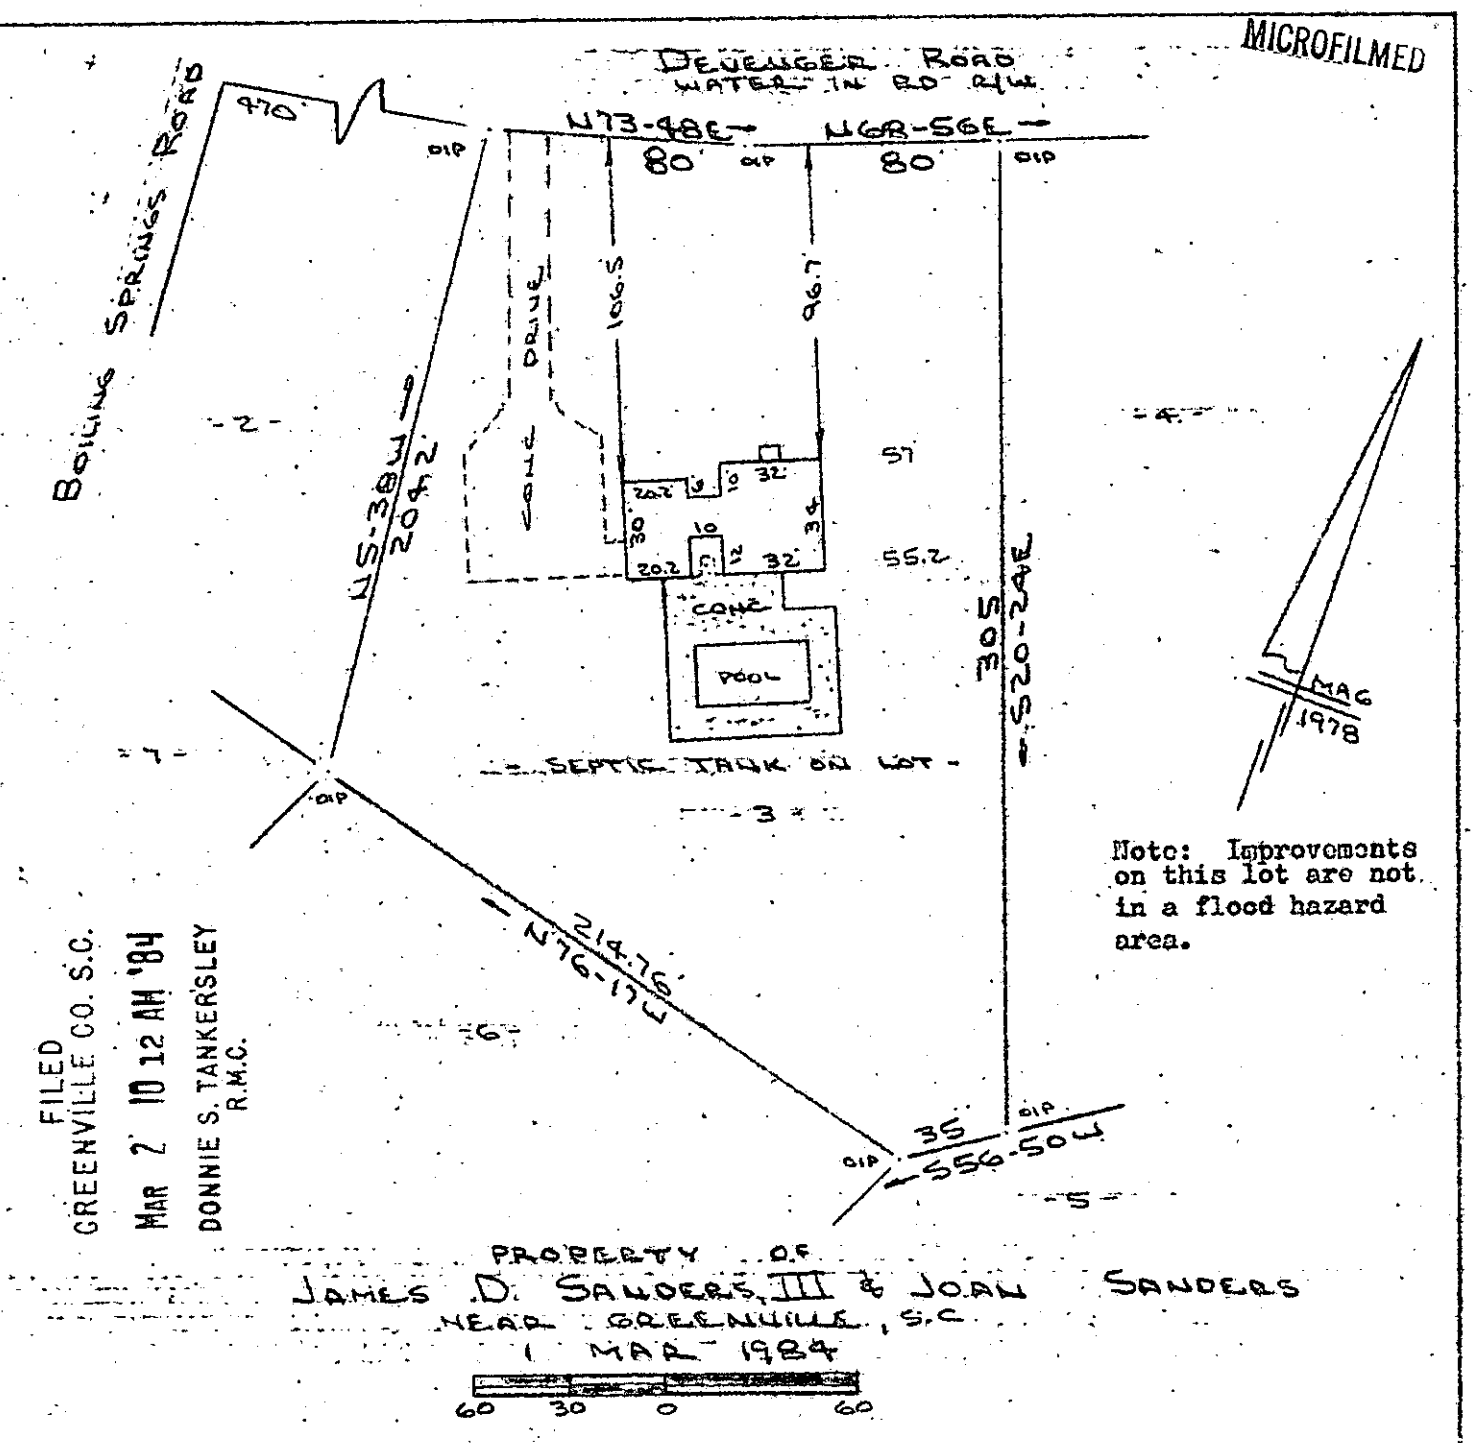


Note: Improvements on this lot are not in a flood hazard area.

FILED
GREENVILLE CO. S.C.
MAR 2 10 12 AM '84
DONNIE S. TANKERSLEY
R.M.C.

This is to certify that on the 1st day of March, 1984, I surveyed the property shown on this plat, being known as lot 3 on plat of SECTION III QUAIL RIDGE and recorded in the RMC Office Greenville County, S. C., in Plat Book " 6 - H " at Page 93; and that the property lines, walls and buildings are as shown hereon, and that the walls and buildings located on said lot do not encroach or project on adjacent street or property, and that no adjacent walls or buildings encroach or project on said premises, and no power lines cross this property except as shown hereon.

27000

10-J-33

R. B. Bruce

R. B. Bruce, RLS #1952

CAROLINA SURVEYING CO.
112 Manly St.
Greenville, S. C.

Recordable Plat

GCTC -----2 MR 2 84 1040

3.00CI