
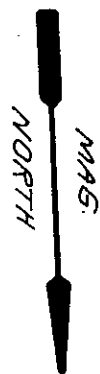


MICROFILMED

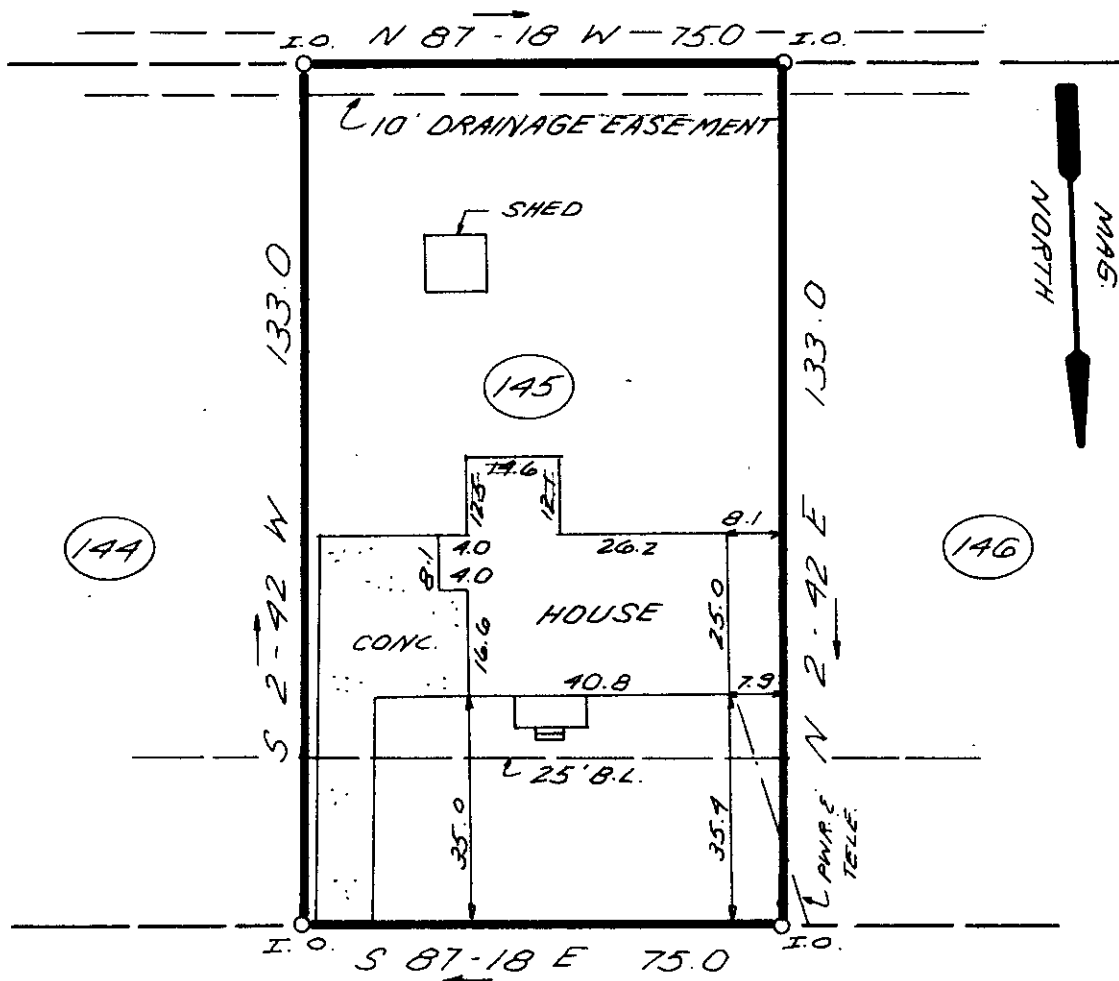

FILED
GREENVILLE CO. S.C.
MAR 7 2 34 PM '84
DONNIE S. TANKERSLEY
R.M.C.

27452

THIS IS TO CERTIFY THAT THE PROPERTY SHOWN ON THIS PLAT WAS SURVEYED UNDER MY DIRECT SUPERVISION. PROPERTY LINES AND IMPROVEMENTS SHOWN ARE LOCATED CORRECTLY AND THAT NO VISIBLE ENCROACHMENTS EXIST UNLESS OTHERWISE SHOWN. THIS PROPERTY IS NOT LOCATED IN A DESIGNATED FLOOD HAZARD AREA.

**STATE OF SOUTH CAROLINA
GREENVILLE COUNTY**

FREELAND & ASSOCIATES
Engineers • Land Surveyors
318 WEST STONE AVENUE.
GREENVILLE, S.C.
(803) 271-4924

KENNEDY PARK
LOT 145
PROPERTY OF
JOHNNIE MELVIN REID SR.
PATRICIA F. REID

PLAT BOOK	JJJ-44
DEED BOOK	1068-315
TAX MAP	386-1-51
PARTY CHIEF	H.B.
DRAWN	K.E.G.
DATE	FEB. 17, 1984
DWG NO	10541

James H. Freeland
REGISTERED LAND SURVEYOR
NO. 4781
STATE OF SOUTH CAROLINA

MLC