

MICROFILMED

S.S. MASON

S.S. MASON


N62-89E
108'

0.82 AC

SEPTIC TANK ON LOT


MAG
1990

FILED
GREENVILLE CO. S.C.
MAR 25 11 25 AM '84
DONNIE S. TAKKERSLEY
R.M.C.

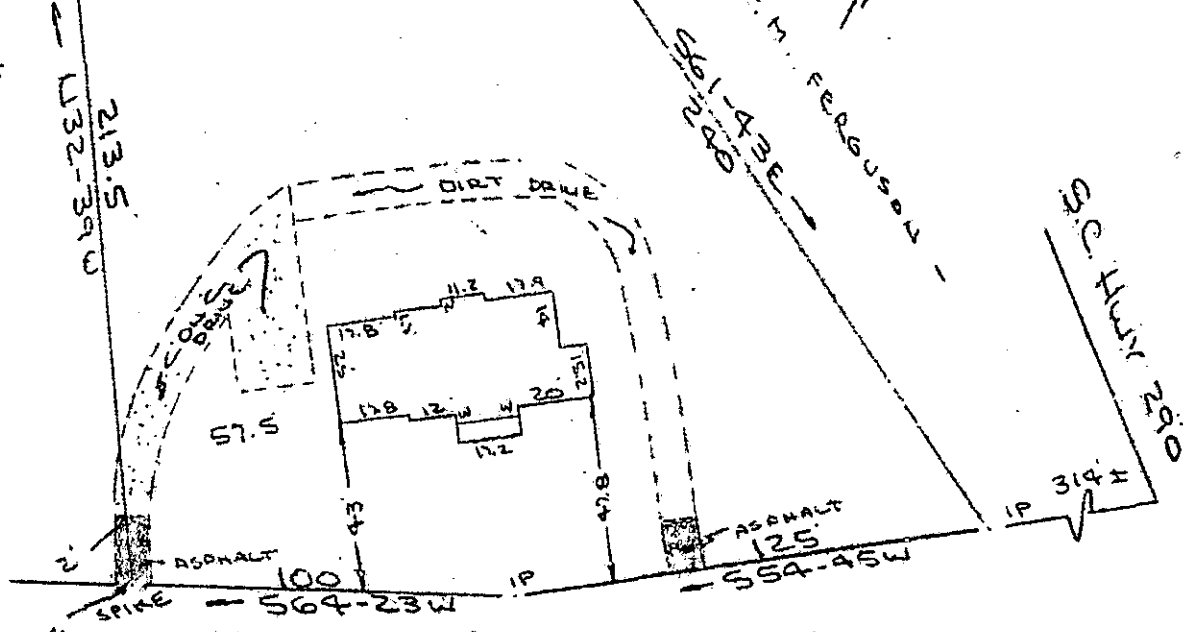

Note:
Improvements on
this lot are not
in a flood hazard
area.

PROPERTY OF
OLIVER N. GREER & MILDRED F. GREER
NEAR GREENVILLE, GREENVILLE COUNTY, S.C.
8 MAR 1984

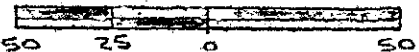


This is to certify that on the 8th day of March, 1984, I surveyed the property shown on this plat, being known as PROPERTY OF OLIVER N. GREER & MILDRED E. GREER and recorded in the RMC Office Greenville County, S. C., in Plat Book " " at Page ; and that the property lines, walls and buildings are as shown hereon, and that the walls and buildings located on said lot do not encroach or project on adjacent street or property, and that no adjacent walls or buildings encroach or project on said premises, and no power lines cross this property except as shown hereon.

28382

MAR 15 1984

10 J-74

R. B. Bruce
R. B. Bruce, RLS # 1952

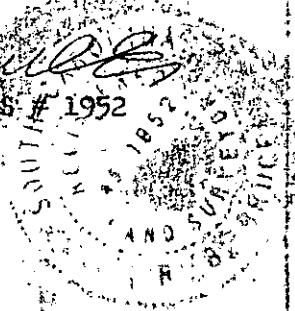

CAROLINA SURVEYING CO.
112 Manly St.
Greenville, S. C.

Recordable Plat