


229

228


226

227

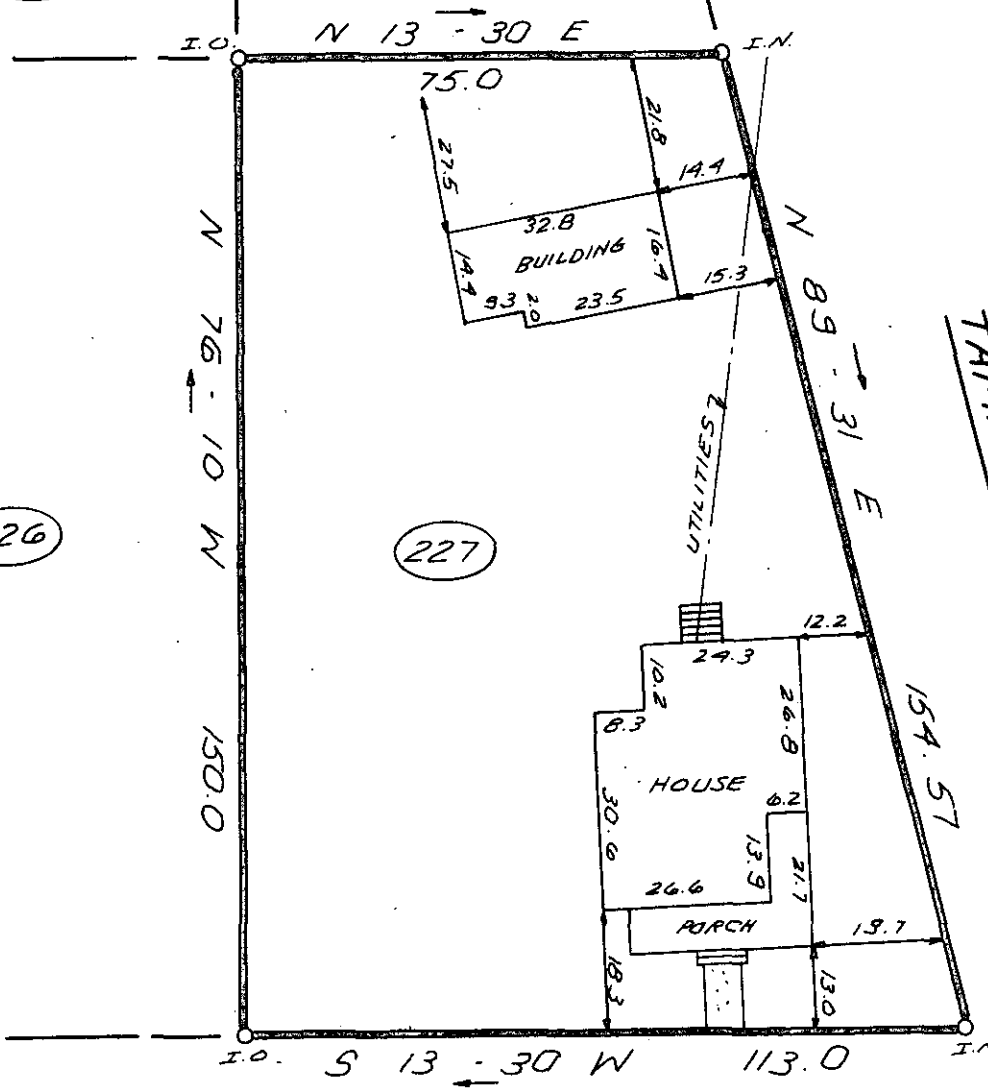

TAMPA STREET

GRIDLEY STREET

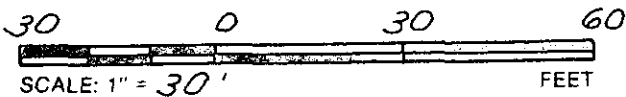

10-2-6

29331

FILED
GREENVILLE CO. S.C.
MAR 23 12 29 PM '84
DONNIE S. TANKERSLEY
R.M.C.

MAR 23 1984

THIS IS TO CERTIFY THAT THE PROPERTY SHOWN ON THIS PLAT WAS SURVEYED UNDER MY DIRECT SUPERVISION. PROPERTY LINES AND IMPROVEMENTS SHOWN ARE LOCATED CORRECTLY AND THAT NO VISIBLE ENCROACHMENTS EXIST UNLESS OTHERWISE SHOWN. THIS PROPERTY IS NOT LOCATED IN A DESIGNATED FLOOD HAZARD AREA.

STATE OF SOUTH CAROLINA
GREENVILLE COUNTY

FREELAND & ASSOCIATES
Engineers • Land Surveyors
318 WEST STONE AVENUE.
GREENVILLE, S.C.
(803) 271-4924

W. B. Huntley III
RLS: W. B. HUNTLEY III
NO: 8809

M^C CARY TRACT
LOT 227
PROPERTY OF
BOBBY L. PEACE
MARY V. PEACE

PLAT BOOK	A-279 & 278
DEED BOOK	860-414
TAX MAP	155-10-3
PARTY CHIEF	B.G.
DRAWN	K.E.G.
DATE	3/22/84
DWG. NO.	10756