


MICROFILMED

FILED
GREENVILLE CO. S.C.

MAR 30 4 47 PM '84


DONNIE S. TANKERSLEY
R.M.C.

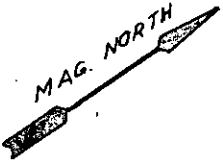

(28)

(27)

(26)

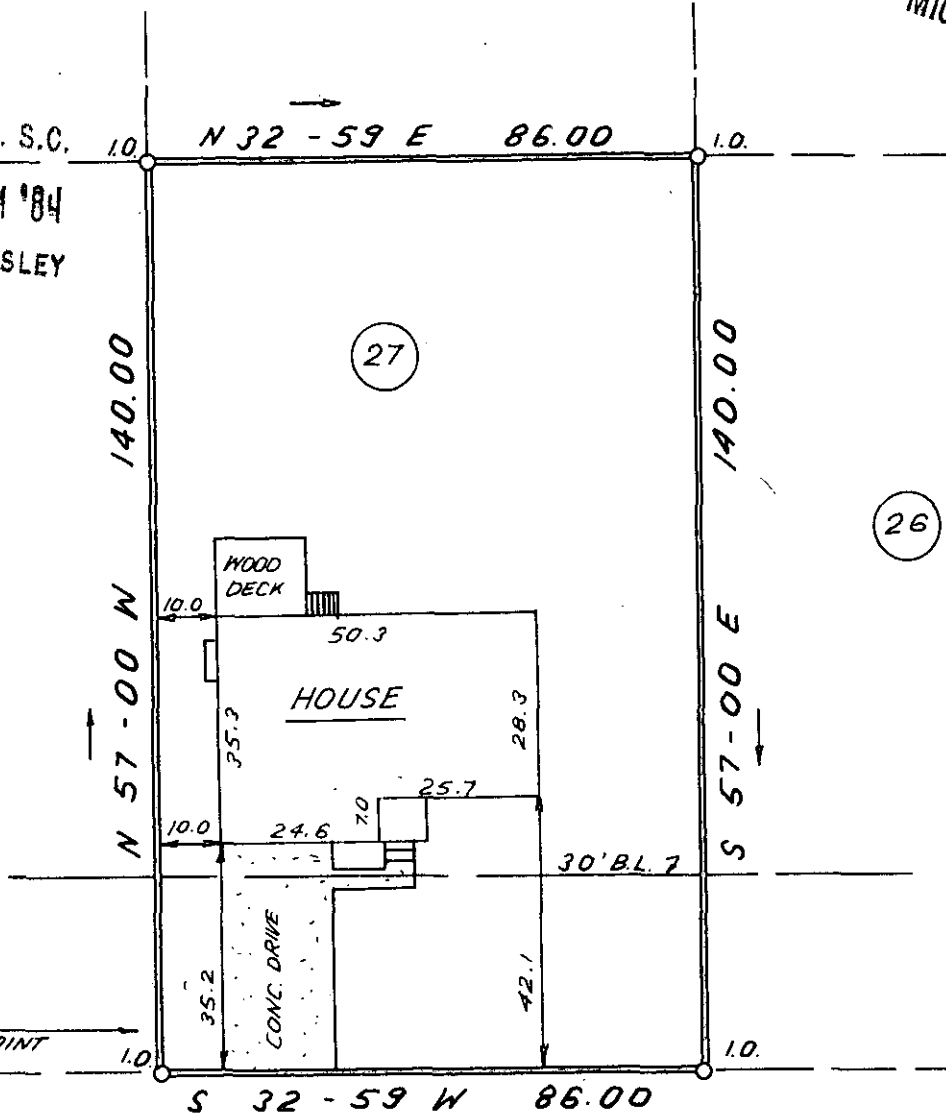


75' ± TO
DEVENGER POINT

ATHERTON WAY

MAR 30 1984

30289

18-7-32

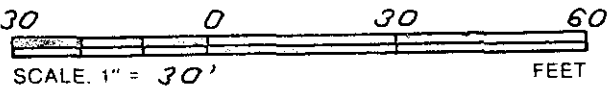

THIS IS TO CERTIFY THAT THE PROPERTY SHOWN ON THIS PLAT WAS SURVEYED UNDER MY DIRECT SUPERVISION. PROPERTY LINES AND IMPROVEMENTS SHOWN ARE LOCATED CORRECTLY AND THAT NO VISIBLE ENCROACHMENTS EXIST UNLESS OTHERWISE SHOWN. THIS PROPERTY IS NOT LOCATED IN A DESIGNATED FLOOD HAZARD AREA.

**STATE OF SOUTH CAROLINA
GREENVILLE COUNTY**

FREELAND & ASSOCIATES
Engineers • Land Surveyors
318 WEST STONE AVENUE.
GREENVILLE, S.C.
(803) 271-4924



DEVENGER POINT
SEC. 1 ; LOT 27
PROPERTY OF
CHARLES J. PROBETT
MOLLY PROBETT

PLAT BOOK	9F - 59
DEED BOOK	
TAX MAP	
PARTY CHIEF	J. E. C.
DRAWN	B. R.
DATE	3 - 22 - 84
DWG. NO.	10762

RLS: W. B. HUNTLEY III.
NO: 8809