
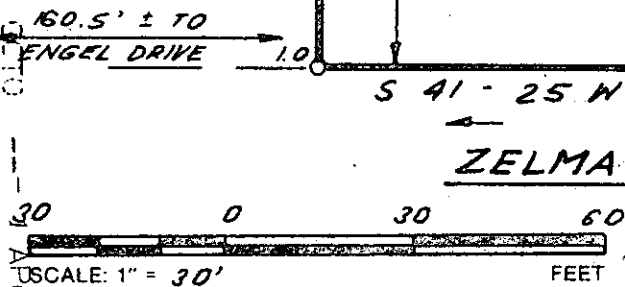


MICROFILMED

FILED  
GREENVILLE CO. S.C.  
APR 2 9 57 AM '84  
DONNIE S. TANKERSLEY  
R.M.C.

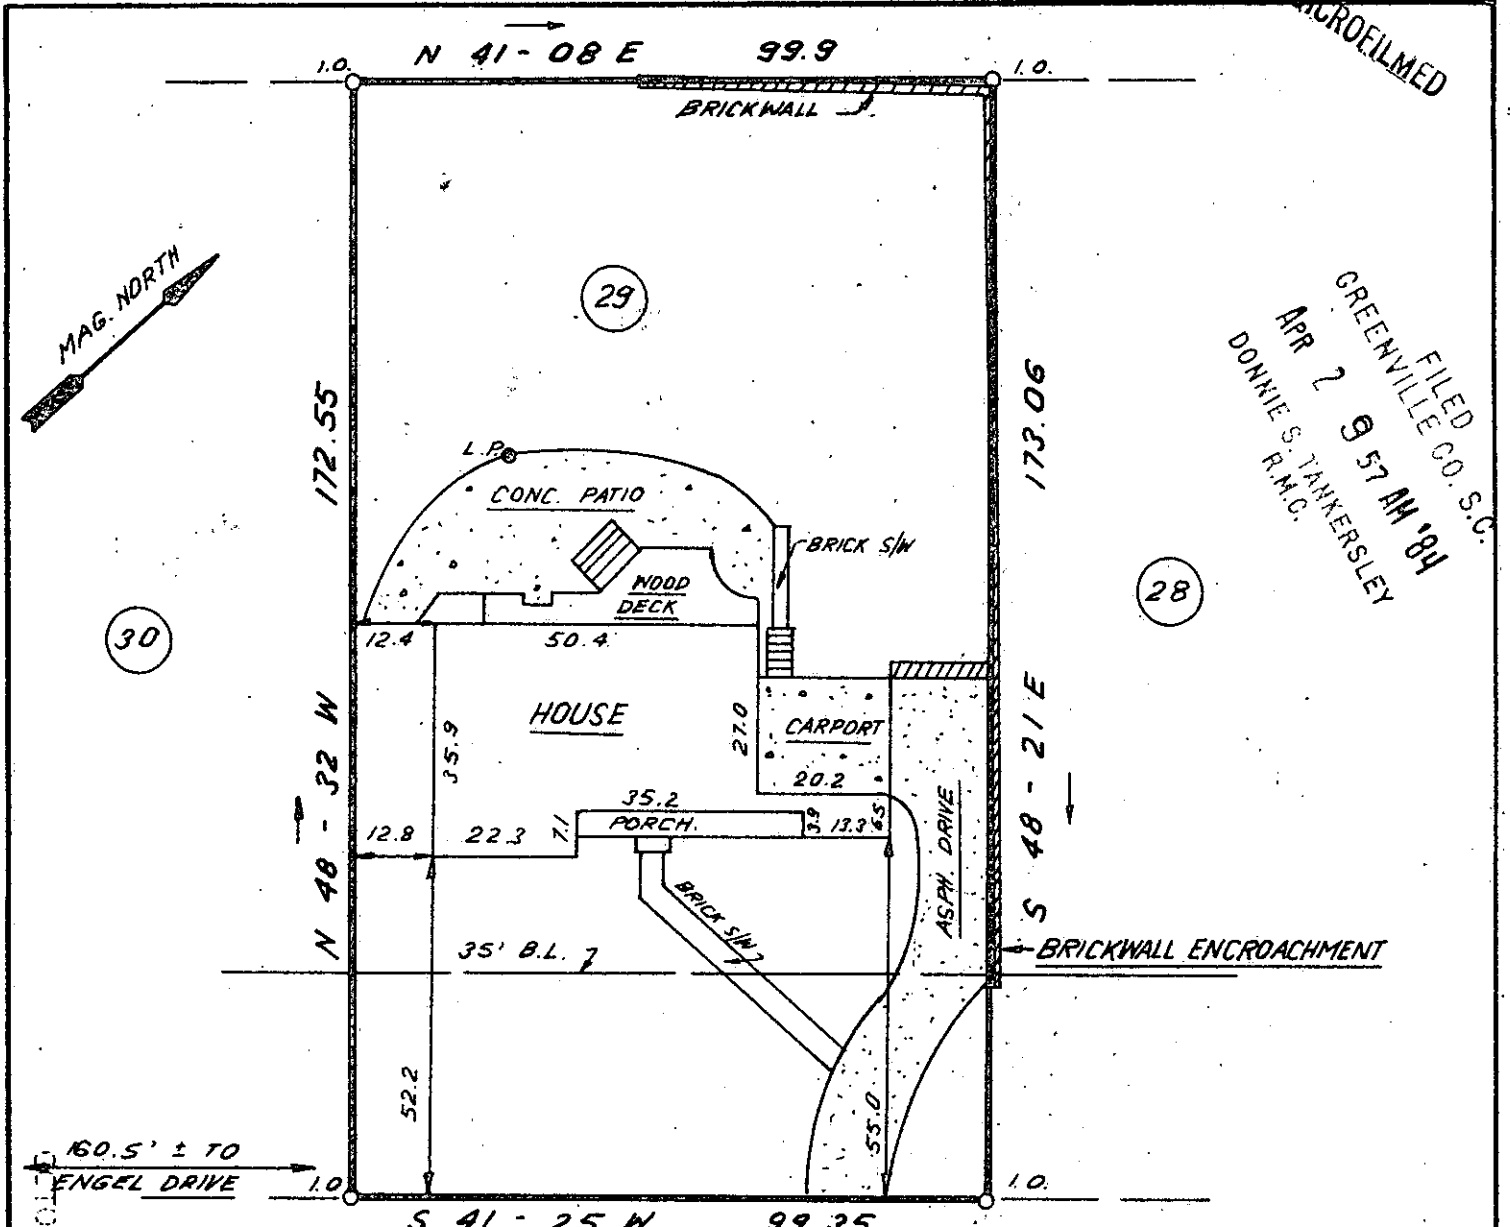

APR 2 1984

30512

✓ 10-6-33

THIS IS TO CERTIFY THAT THE PROPERTY SHOWN ON THIS PLAT WAS SURVEYED UNDER MY DIRECT SUPERVISION. PROPERTY LINES AND IMPROVEMENTS SHOWN ARE LOCATED CORRECTLY AND THAT NO VISIBLE ENCROACHMENTS EXIST UNLESS OTHERWISE SHOWN. THIS PROPERTY IS NOT LOCATED IN A DESIGNATED FLOOD HAZARD AREA.

329

SOUTH CAROLINA  
REGISTERED SURVEYOR  
4781  
JAMES R. FREELAND

RLS: JAMES R. FREELAND  
NO: 4781

STATE OF SOUTH CAROLINA  
GREENVILLE COUNTY

OAKLAND TERRACE  
LOT 29  
PROPERTY OF  
J. RICHARD BRAKEFIELD  
ROBERTA C. BRAKEFIELD

FREELAND & ASSOCIATES  
Engineers • Land Surveyors  
318 WEST STONE AVENUE.  
GREENVILLE, S.C.  
(803) 271-4924

PLAT BOOK	B.B. 196
DEED BOOK	
TAX MAP	429-1-34
PARTY CHIEF	H.B.
DRAWN	B.R.
DATE	3-27-84
DWG. NO.	10777