


MAR 1985

FILED
GREENVILLE CO. S.C.
APR 2 1 10 PM '84
DONNIE J. JAKRENSLEY
R.M.C.

- 32 -

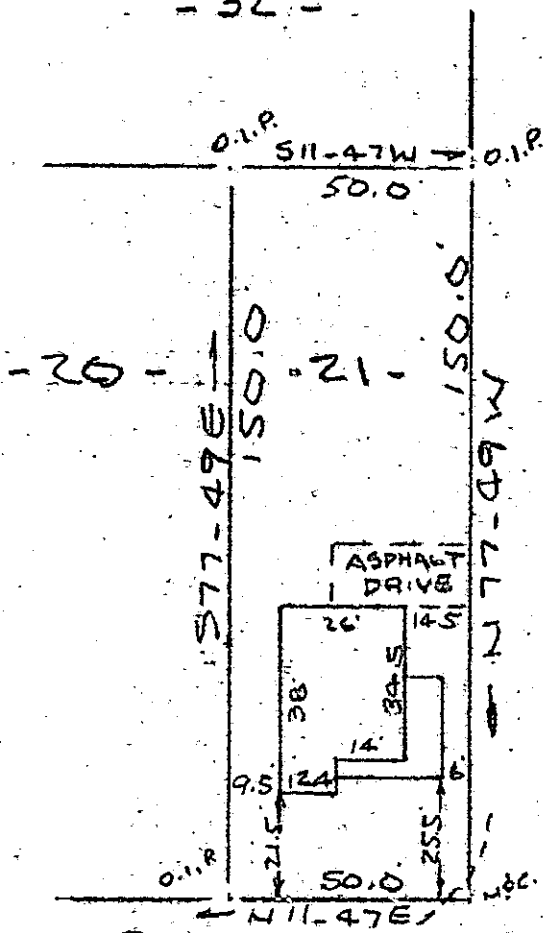


HAWKINS STREET

Note: Improvements on this lot are not in a flood hazard area.

PIEDMONT AVENUE
WATER & SEWER IN ST. R/W.

APR 2 1984

PROPERTY OF
MYRON SCOTT PARIS & TERRI ELIZABETH HENRY
GREER, GREENVILLE COUNTY S.C.
SCALE 1" = 40' 26 MARCH 1984

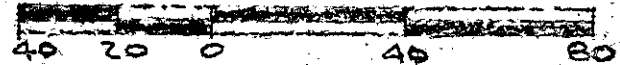

This is to certify that on the 26th day of March, 1984, I surveyed the property shown on this plat, being known as lot 21 on plat of MORROW HEIGHTS and recorded in the RMC Office Greenville County, S. C., in Plat Book " D " at Pages 196 & 197 and also known as PROPERTY OF MYRON SCOTT PARIS & TERRI ELIZABETH HENRY and recorded in Plat Book at Page ; and that the property lines, walls and buildings are as shown hereon, and that the walls and buildings located on said lot do not encroach or project on adjacent street or property, and that no adjacent walls or buildings encroach or project on said premises, and no power lines cross this property except as shown hereon.

10-2-43

30623

R. B. Bruce
B. B. Bruce, RLS #1952

CAROLINA SURVEYING CO.
112 Manly St.
Greenville, S.C. 29602

Recordable Plat
3.00 CD

269/2

914-1-10