

MICROFILMED


FILED
GREENVILLE CO. S.C.

APR 2 3 50 PM '84

DONNIE S. TANKERSLEY

R.M. 1949

- JULIAN E. HARMON -

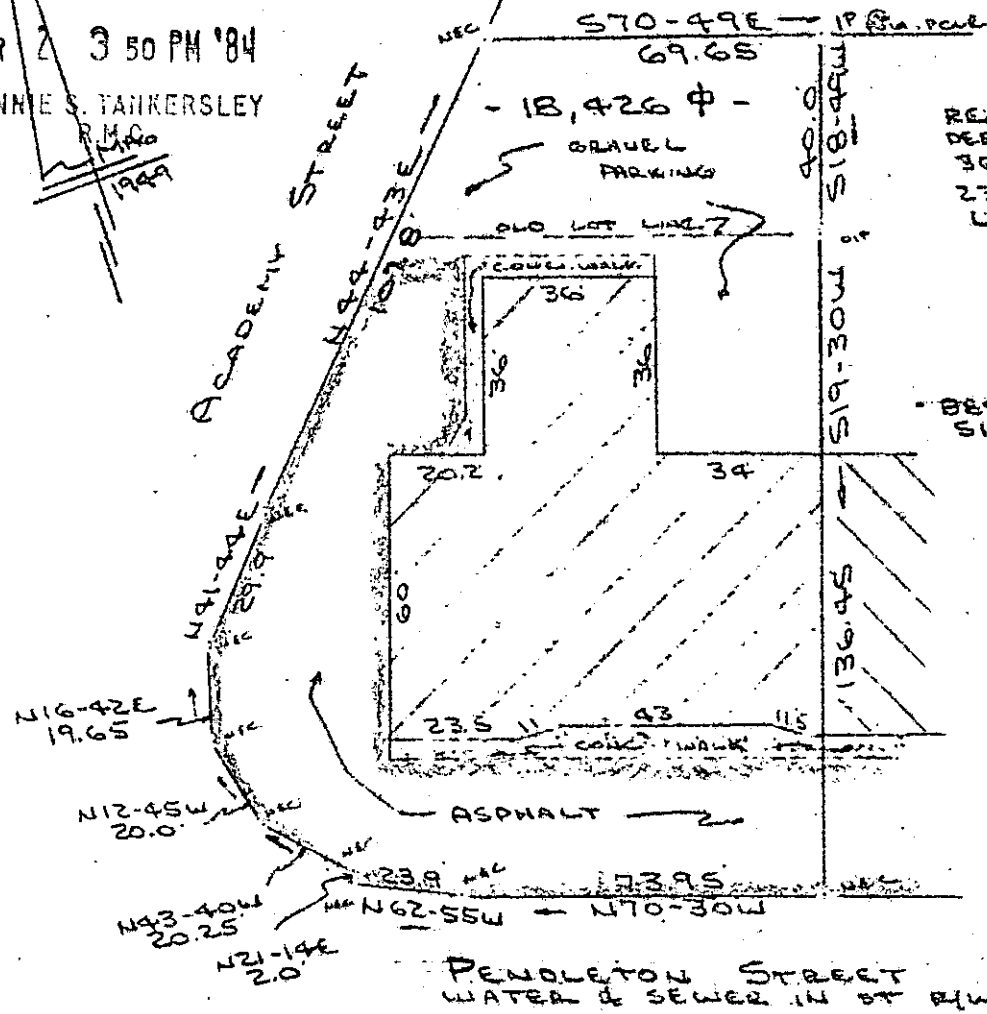


REF: PLAT BK 209
DEED BK 222 @ 357 -
361 & S.C.H.D. FILE
23,540 PROJECT
U-2627(2).

- BESSIE J
SINCHOS -

Note: Improvements
on this lot are not
in a flood hazard
area.

PROPERTY OF
CLEMSON N. SMITH
GREENVILLE COUNTY, GREENVILLE, S.C.
29 MAR 1984

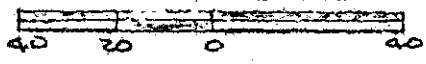

This is to certify that on the 29th day of March, 1984, I surveyed the property shown on this plat, being known as PROPERTY OF CLEMSON N. SMITH and recorded in the REC Office Greenville County, S. C., in Plat Book at Page and that the property lines, walls and buildings are as shown hereon, and that the walls and buildings located on said lot do not encroach or project on adjacent street or property, and that no adjacent walls or buildings encroach or project on said premises, and no power lines cross this property except as shown hereon.

10-L-44
APR 2 1984

R. B. Bruce, RLS 1952
REGISTERED SURVEYOR

30617

CAROLINA SURVEYING CO.
112 Manly St.
Greenville, S. C.

Recordable Plat

2 APO2 84

749

3.00CI