MICROFILMED

FILED
GREENVILLE CO. S.C.
APR 2 4 22 PM '84
DONNIE S. TANKERSLEY
R.M.C.

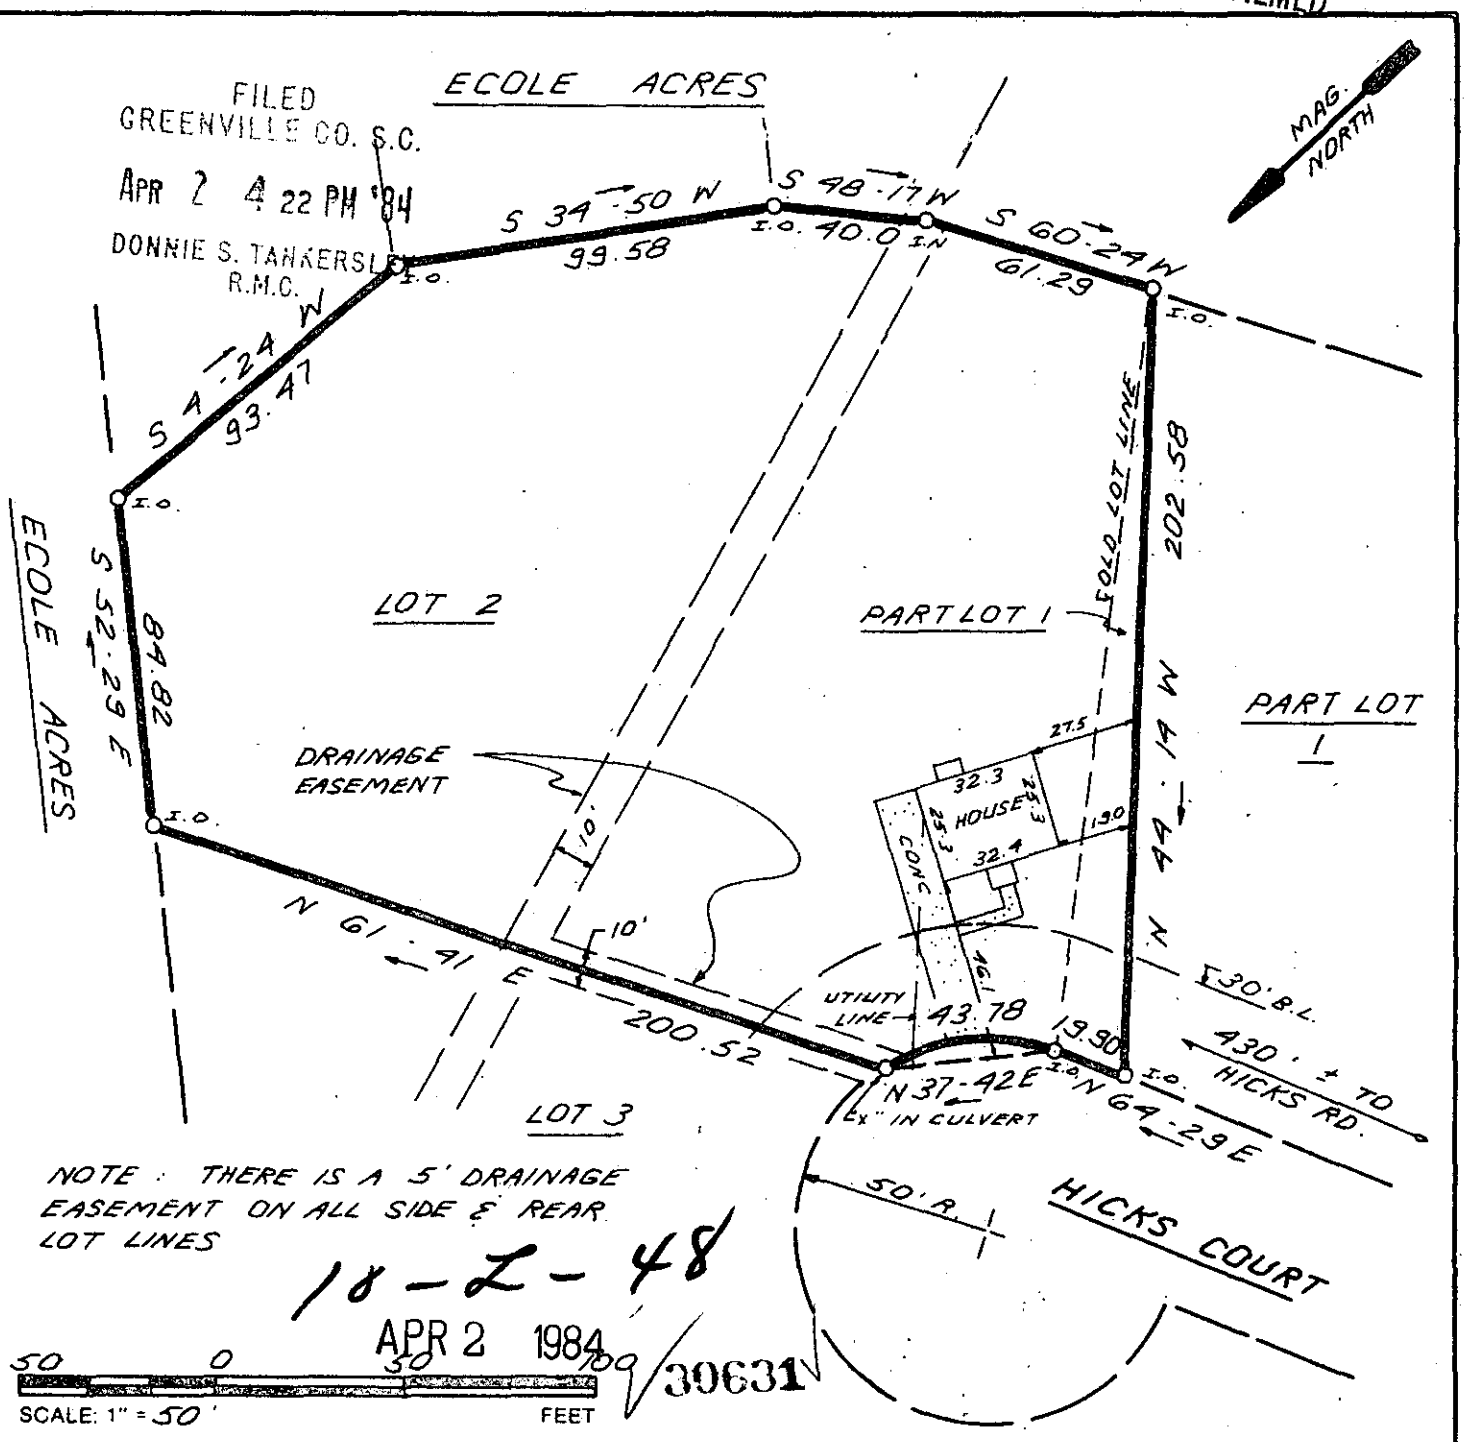

NOTE: THERE IS A 5' DRAINAGE EASEMENT ON ALL SIDE & REAR LOT LINES

18-L-48

APR 2 1984

30631

SCALE: 1" = 50' FEET

THIS IS TO CERTIFY THAT THE PROPERTY SHOWN ON THIS PLAT WAS SURVEYED UNDER MY DIRECT SUPERVISION. PROPERTY LINES AND IMPROVEMENTS SHOWN ARE LOCATED CORRECTLY AND THAT NO VISIBLE ENCROACHMENTS EXIST UNLESS OTHERWISE SHOWN. THIS PROPERTY IS NOT LOCATED IN A DESIGNATED FLOOD HAZARD AREA.

SOUTH CAROLINA REGISTERED LAND SURVEYOR 8809

RLS: W. B. HUNTLEY III
NO: 8809

STATE OF SOUTH CAROLINA
GREENVILLE COUNTY

ELCOLE ACRES
SEC. 2. ; LOT 2 & PT. LOT 1
PROPERTY OF
RODDIE TILTON LATIMER & RUBY LEE ADAMS

FREELAND & ASSOCIATES
Engineers • Land Surveyors
318 WEST STONE AVENUE.
GREENVILLE, S.C.
(803) 271-4924

PLAT BOOK	4R - 90
DEED BOOK	1044 - 141
TAX MAP	394 - 1 - 45
PARTY CHIEF	R. J.
DRAWN	K.E.G.
DATE	3/21/84
DWG. NO.	10755