


MICROFILMED

FILED
GREENVILLE CO. S.C.

APR 2 4 46 PM '84

DONNIE S. TARKERSLEY
R.M.C.


Note:
Improvements
on this lot
are not in
a flood
hazard area.

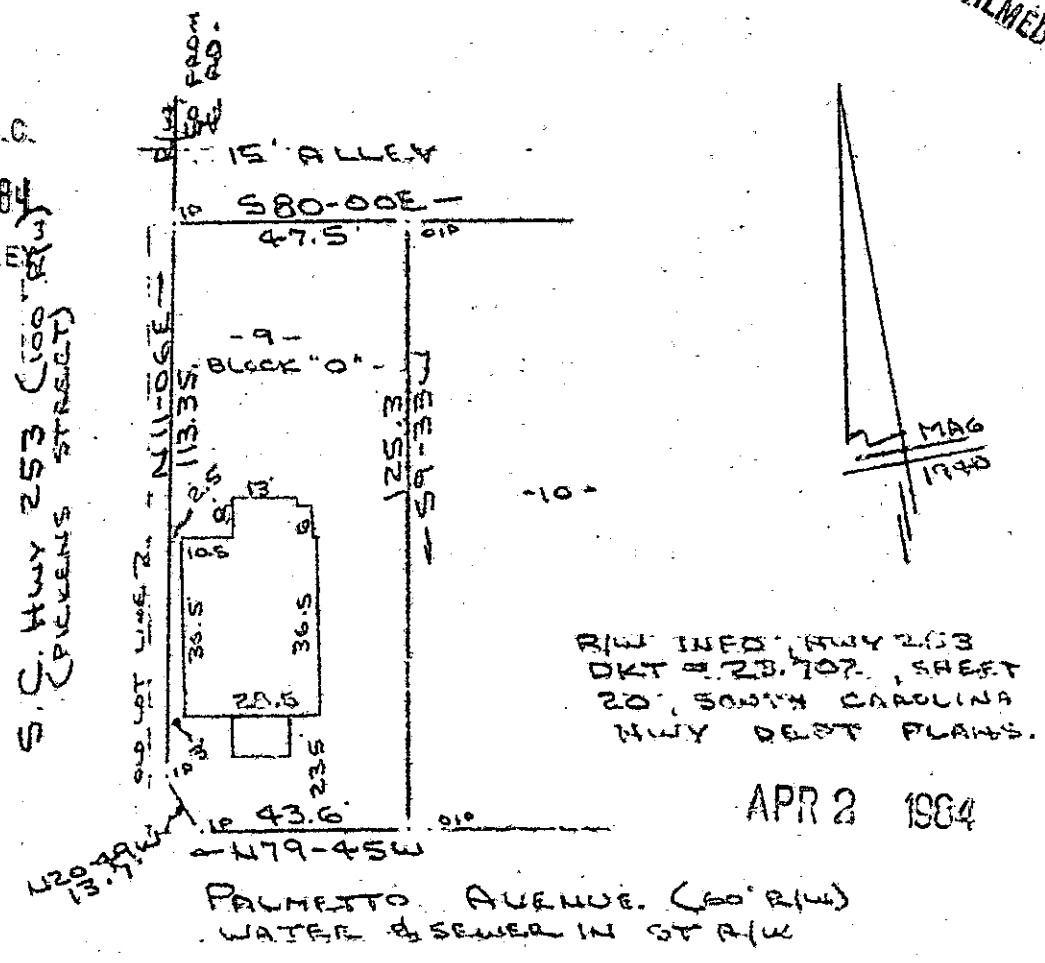

APR 2 1984

10-2-49

PROPERTY OF
STEVE D. BALL & KITTY D. BALL
NEAR GREENVILLE, GREENVILLE COUNTY, S.C.
30 MAR 1984

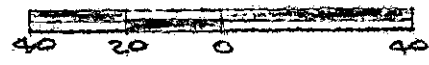

This is to certify that on the 30th day of March, 1984, I surveyed the property shown on this plat, being known as lot 9 Block "O" RIVERSIDE and recorded in the RMC Office Greenville County, S. C., in Plat Book "A" at Pages 382 & 383; and also known as PROPERTY OF STEVE D. BALL & KITTY D. BALL and recorded in Plat Book at Page ; and that the property lines, walls and buildings are as shown hereon, and that the walls and buildings located on said lot do not encroach or project on adjacent street or property, and that no adjacent walls or buildings encroach or project on said premises, and no power lines cross this property except as shown hereon.

R. B. Bruce
R. B. Bruce, RLS #1952

Recordable Plat

CAROLINA SURVEYING CO.
112 Manly St.
Greenville, S. C.

30632

---3 AP02 84 059

