


MICROFILED

~~2 NOV  
1983~~

MILLER ROAD (EAST FOX STREET)

DONALD E. FEAGAN -

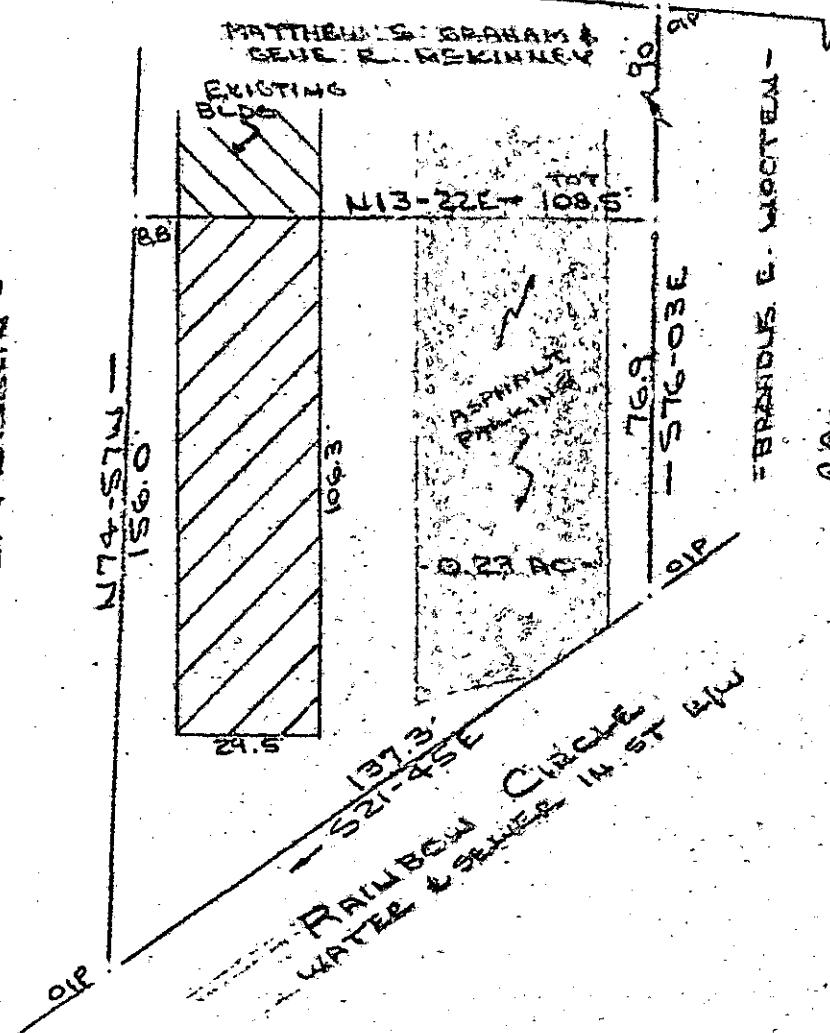

REED DEED BK 1164  
@ PAGE 897, REC. 10  
VILLE CO. REC. OFFICE.

Note:  
Improvements on this  
lot are not in a  
flood hazard area.

FILED  
GREENVILLE CO. S.C.

APR 6 12 43 PM '84

DONNIE S. TANKERSLEY  
R.M.C.

PROPERTY OF

MATTHEW S. GRAHAM & GENE R. MCKINNEY

GREENVILLE COUNTY, HAWLDRIDGE, S.C.

7 NOV 1983

20 20 0 20

This is to certify that on the 7th day of November, 1983, I surveyed the property shown on this plat, being known as PROPERTY OF MATTHEW S. GRAHAM & GENE R. MCKINNEY and recorded in the REC Office Greenville County, S. C., in Plat Book at Page ; and that the property lines, walls and buildings are as shown hereon, and that the walls and buildings located on said lot do not encroach or project on adjacent street or property, and that no adjacent walls or buildings encroach or project on said premises, and no power lines cross this property except as shown herein.

31263

Recordable Plat 10-L-62

R. B. Brueck  
R. B. Brueck, RLS # 1952

CAROLINA SURVEYING CO.  
112 Main St.  
Greenville, S. C.