LINE	BEARING	DISTANCE
1	N 44°48'00"W	45.00
2	N 26°13'59"E	0.92
3	N 43°30'16"E	45.02
4	N 42°20'15"E	40.05
5	N 38°46'52"E	40.25
6	N 48°46'35"E	40.08
7	N 61°18'48"E	46.84
8	N 49°28'02"E	40.11
9	N 82°48'29"E	44.18
10	N 44°48'00"W	4.83
11	N 44°48'00"W	13.00
12	N 44°48'00"W	13.00
13	N 44°48'00"W	18.00
14	N 44°48'00"W	15.50
15	N 44°48'00"W	10.00
16	N 44°48'00"W	17.00
17	N 44°48'00"W	9.00

PLAT REVISIONS

1. PLAT REVISED 2 FEB 84 TO SHOW CHANGES ON LOTS 1 & 3 SEC. I AND 1, 3, & 5 SEC. II
2. PLAT REVISED 29 FEB 84, TO SHOW CHANGES ON LOTS 10 AND 12 SEC. I.
3. PLAT REVISED 16 MAR 84 TO SHOW CHANGES ON LOTS 10 AND 12 SEC. I.
4. PLAT REVISED 22 JUN 84 TO SHOW ORIGINAL LOT LINES ON LOTS 1 & 3 SEC. I. RECORDING INFORMATION OF PB 9W - Pp. 37 IS VOIDED.
5. REVISED BOUNDARY ON LOT 6, SEC. 2, 31 JULY 1984
6. PLAT REVISED 23 JAN 1985

FILED
GREENV... S.C.
Feb 25 4 ... PM '85
DORIS ... LEY

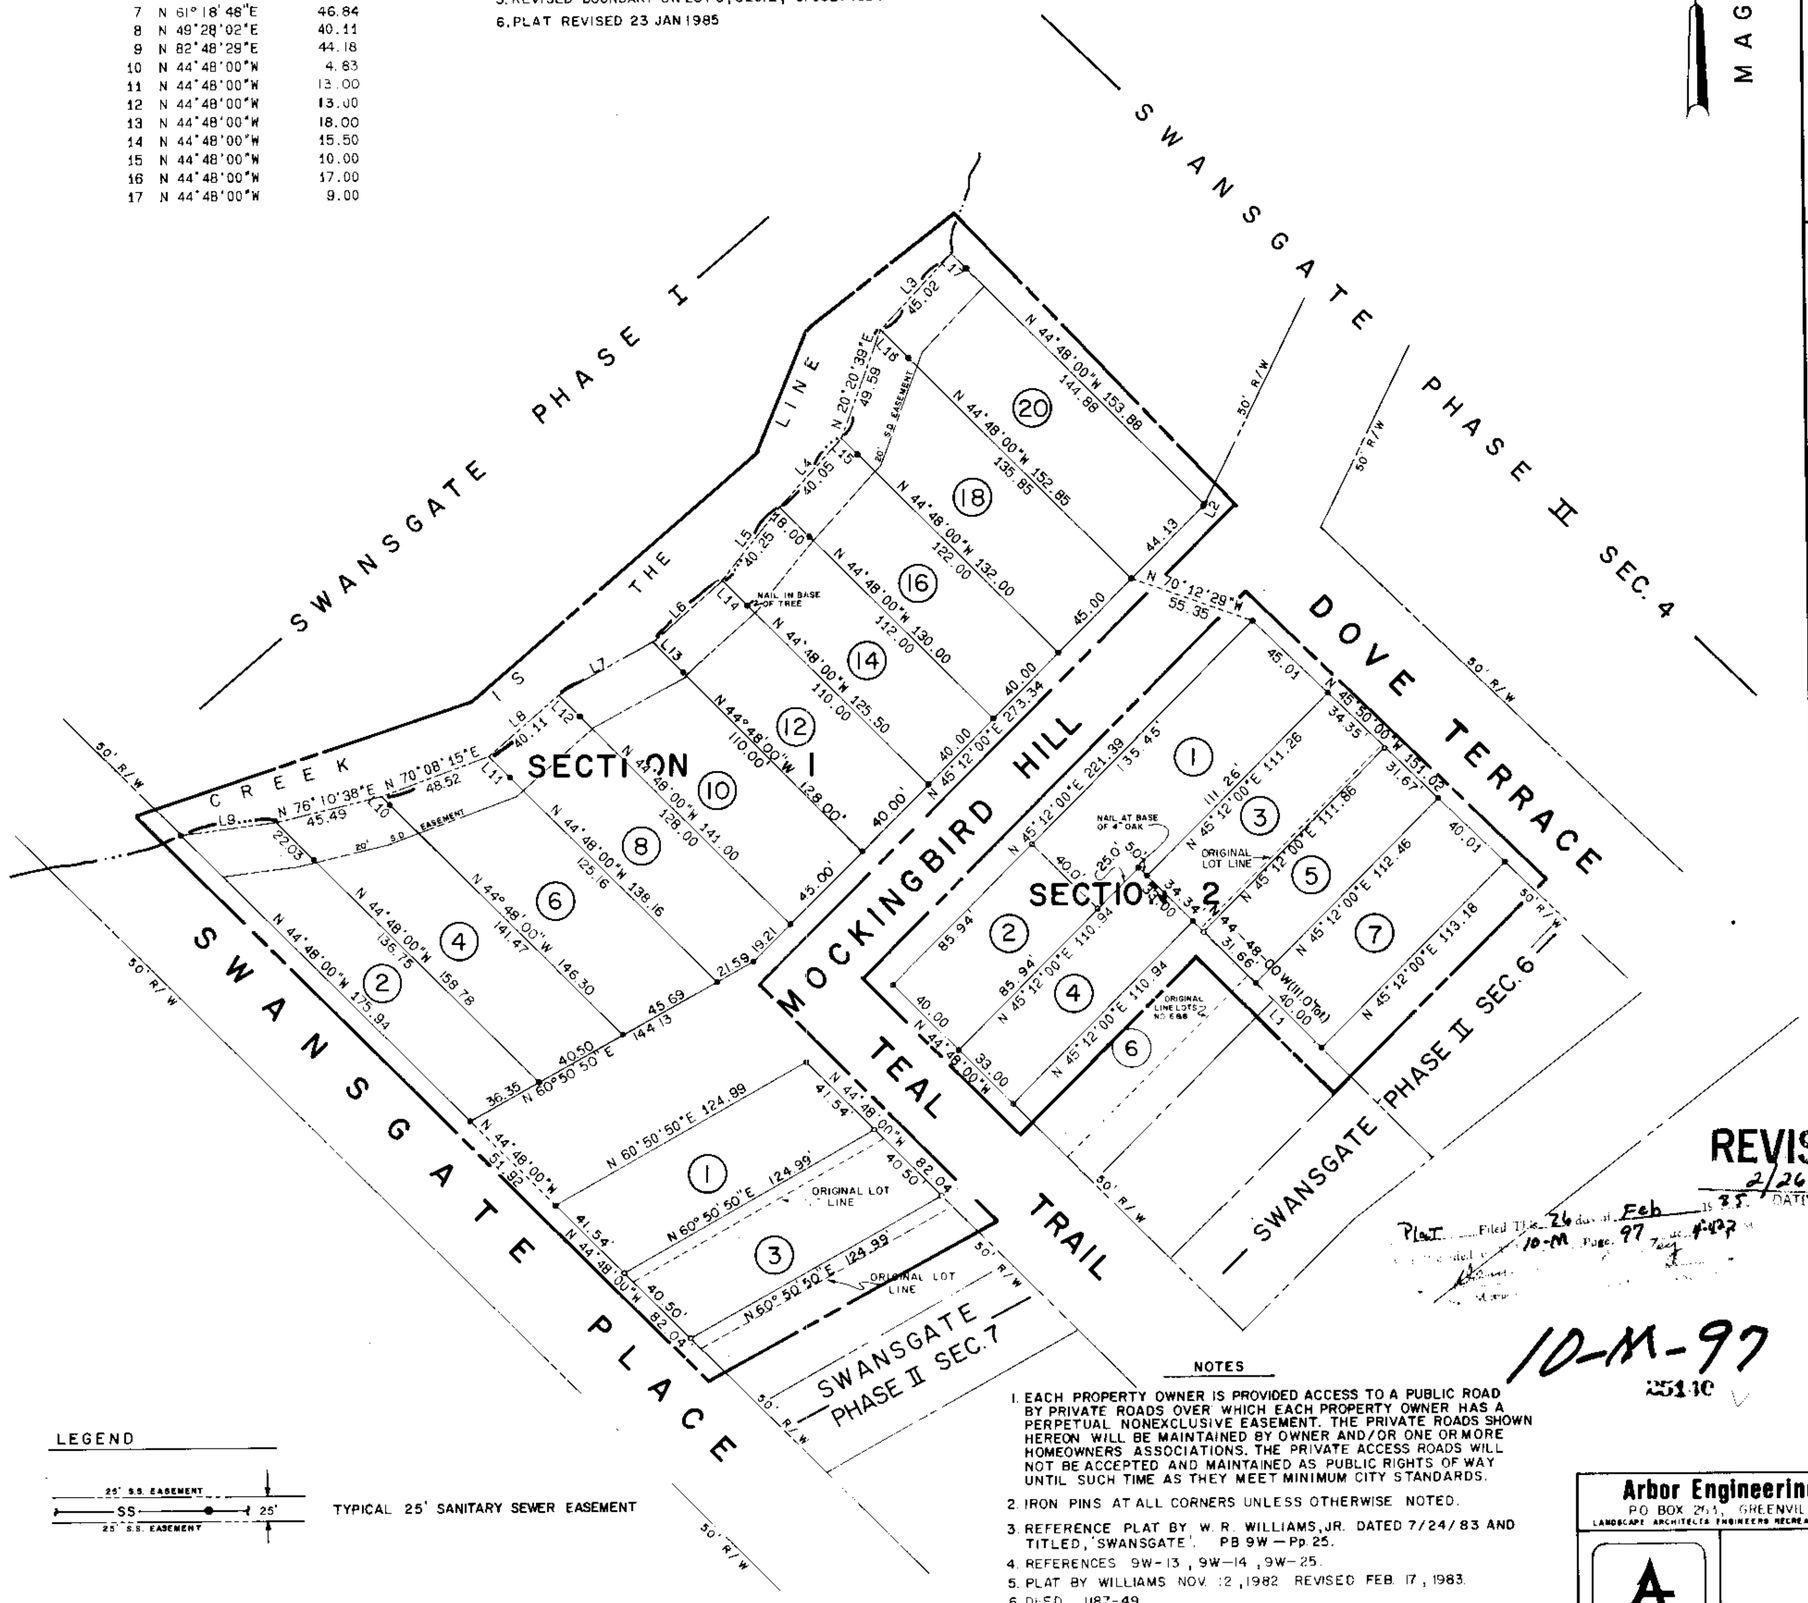
MAGNETIC
SWANSGATE PHASE I
SWANSGATE PHASE II SEC. 4
SWANSGATE PHASE II SEC. 6
SWANSGATE PHASE II SEC. 7
THE DOVE TERRACE
MOCKINGBIRD HILL
TEAL TRAIL
SWANSGATE PLACE
CREEK
SECTION 1
SECTION 2
50' R/W
20' S.S. EASEMENT
NAIL IN BASE OF TREE
NAIL AT BASE OF 4" OAK
ORIGINAL LOT LINE
ORIGINAL LINE LOTS 2 NO. 6&8
N 44°48'00"W 153.88
N 44°48'00"W 152.85
N 44°48'00"W 132.00
N 44°48'00"W 130.00
N 44°48'00"W 125.50
N 44°48'00"W 128.00
N 44°48'00"W 141.00
N 44°48'00"W 138.16
N 44°48'00"W 146.30
N 44°48'00"W 175.94
N 60°50'50"E 124.99
N 45°12'00"E 221.39
N 45°12'00"E 111.26
N 45°12'00"E 110.94
N 45°12'00"E 112.46
N 45°12'00"E 113.18
N 70°12'29"W 55.35
N 20°20'39"E 49.59
N 76°10'38"E 45.49
N 70°08'45"E 48.52
N 60°50'50"E 144.13
N 44°48'00"W 82.04
N 44°48'00"W 33.00
N 44°48'00"W 31.66
N 44°48'00"W 31.67
N 44°48'00"W 34.35
N 44°48'00"W 31.67
N 44°48'00"W 40.00
N 45°12'00"E 273.34
N 45°12'00"E 110.94
N 45°12'00"E 111.86
