MICROFILMED

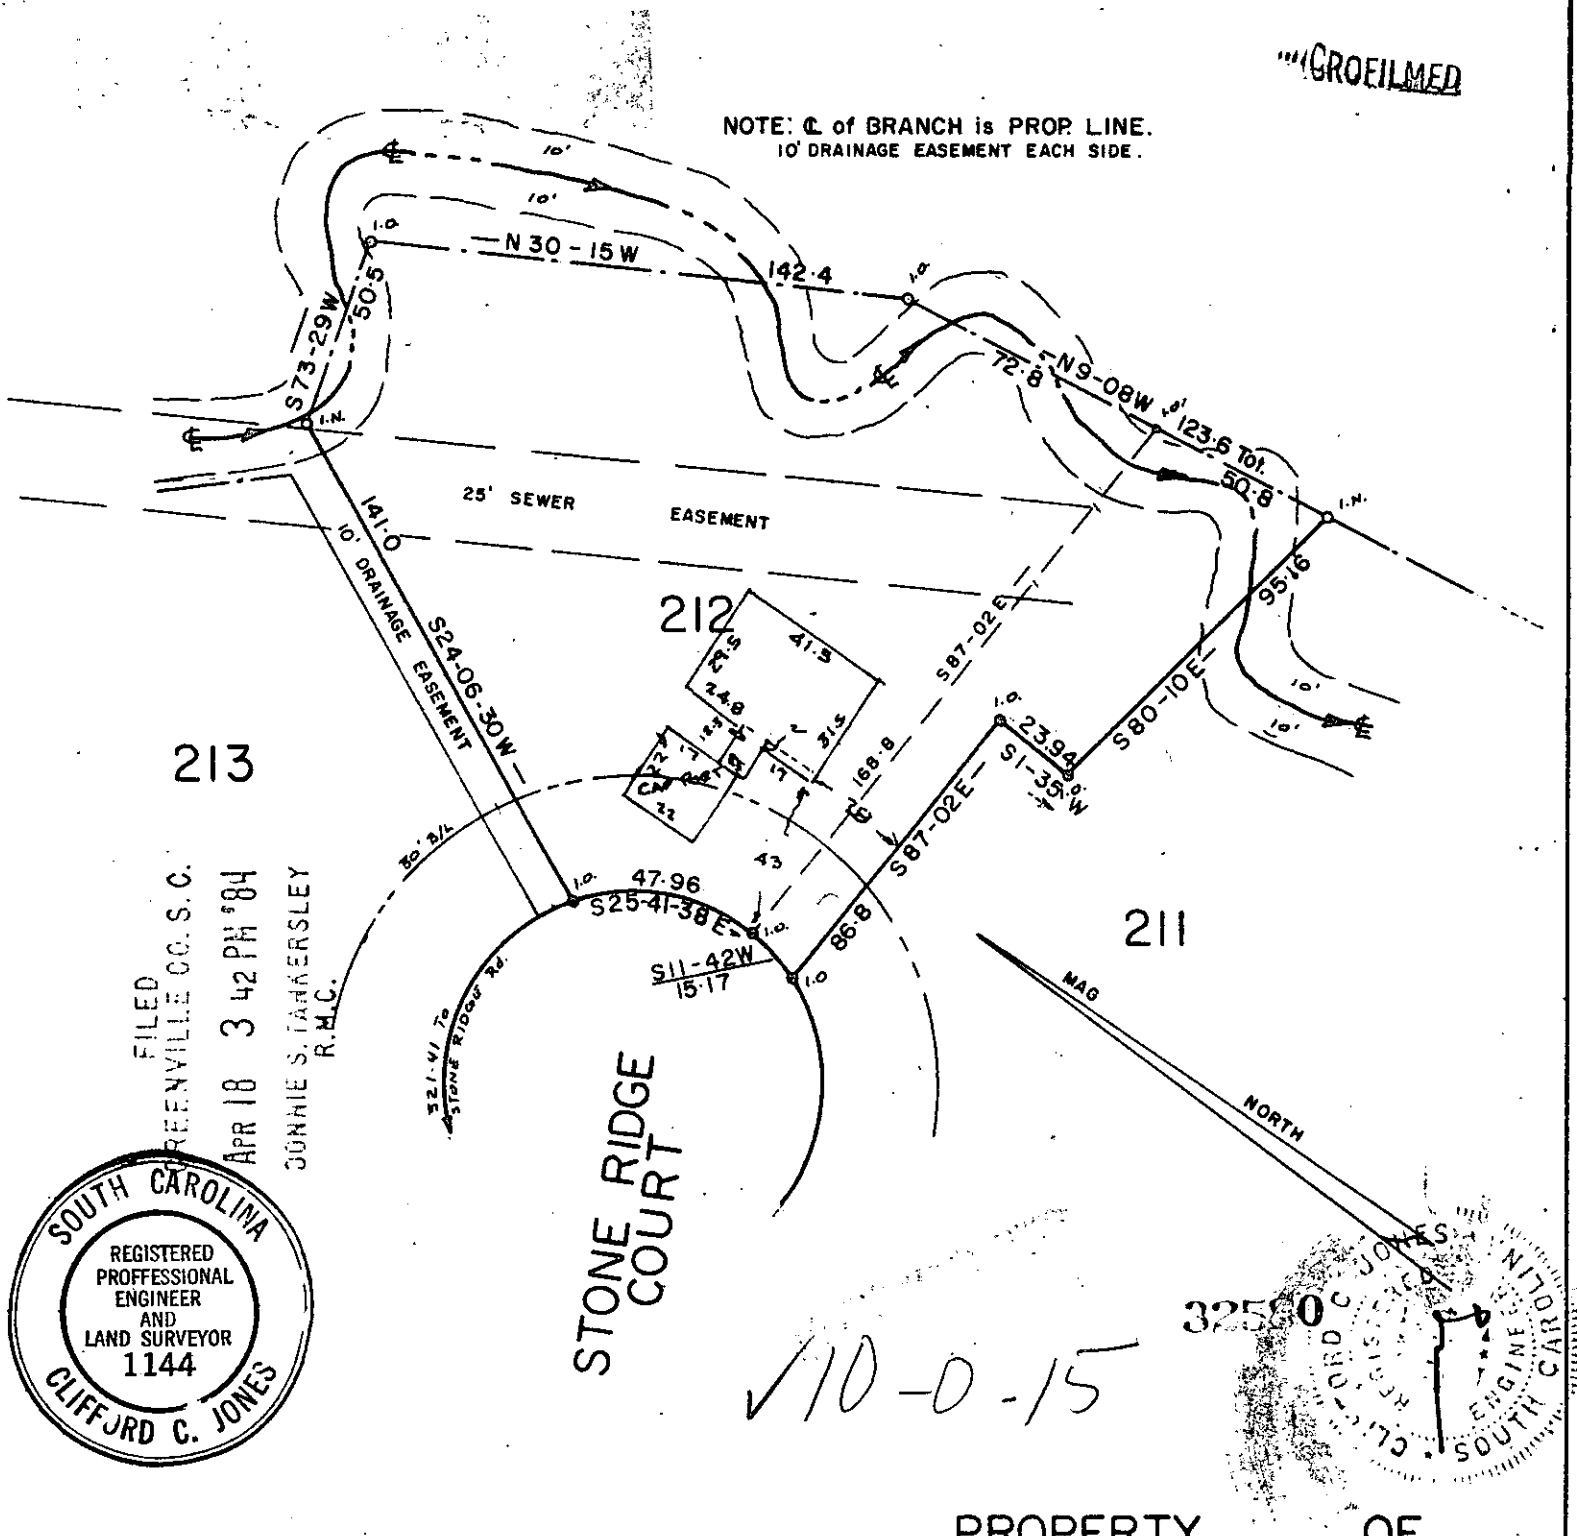

FILED
GREENVILLE CO. S. C.
APR 18 3 42 PM '84
DONNIE S. TANKERSLEY
R.M.C.

SOUTH CAROLINA
REGISTERED
PROFFESSIONAL
ENGINEER
AND
LAND SURVEYOR
1144
CLIFFORD C. JONES

10-0-15

PROPERTY OF

RONALD P. MATLOCK —
DONNA R. MATLOCK

GREENVILLE COUNTY, S. C.

APR 16. 1984

SCALE 1"= 50'

0 10 20 30 40 50 100

. . . to certify that on the 16th day of April 1984, I surveyed the property shown on this plat, being Map 2 Sec 1 Duncan Woods, recorded in Plat Book 4-R, Page 85 of the R.M.C Office for Greenville County, S. C., and that the property lines, walls and buildings are as shown hereon; that the buildings located on said lot do not encroach or project on adjacent streets or property; and that no adjacent buildings or walls encroach or project on said premises, and that no utility lines cross this property.

Reg. Engineer No. 1144 S.C

BOOK ——— 2 AP18 84

Jones Engineering Service 1006 East Perry Rd, Greenville, S. C. 29609