MICROFILMED

FILED
GREENVILLE CO. S.C.
APR 19 9 16 AM '84
DONNIE S. TANKERSLEY
R.M.C.

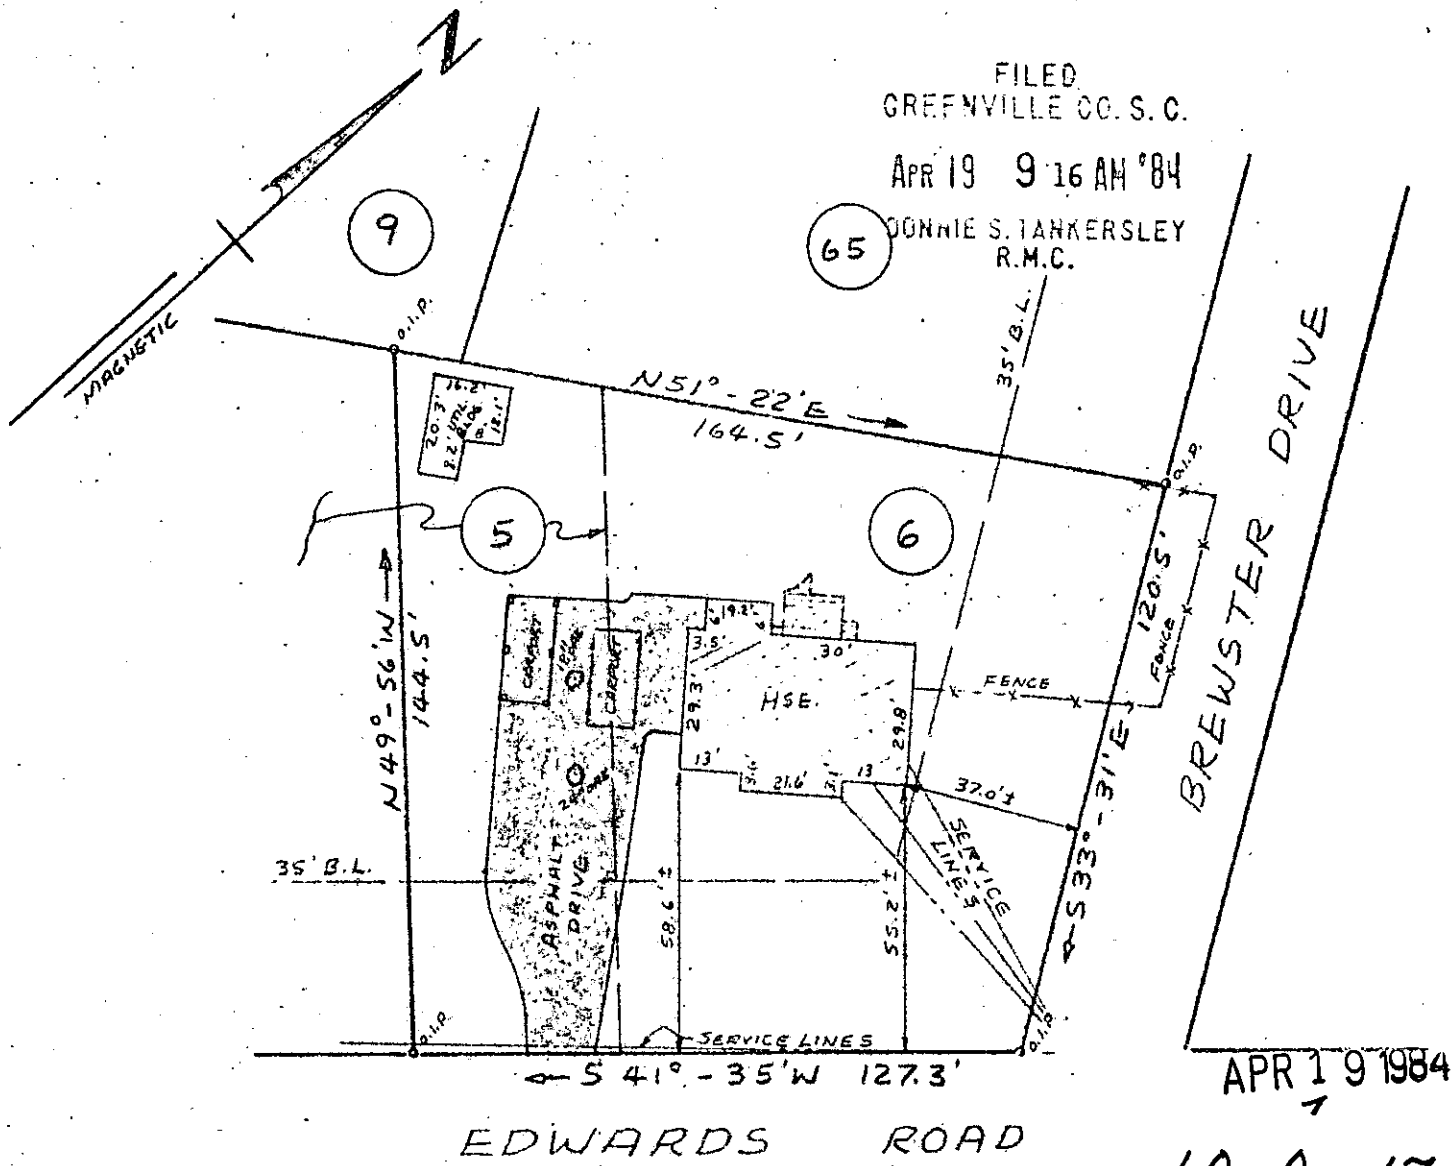

APR 19 1984

10-0-17

32642

PROPERTY OF

DALE C. WESTERMEIER & JAN C. WESTERMEIER

NEAR GREENVILLE, GREENVILLE CO., S.C.

APRIL 10, 1984 SCALE: 1" = 40'

This is to certify that on April 10, 1984, I surveyed the property shown on this plat known as Lot No. 6 and a part of Lot No. 5 of PINE BROOK as recorded in the RMC Office for Greenville County in Plat Book Z at Page 148, and that the property lines, walls and buildings are as shown hereon, and that the buildings located on said lot do not project nor encroach on adjacent streets or property, and that no adjacent walls or buildings project nor encroach on said lot, and that no utility lines cross this lot except as may be shown hereon. The degree of accuracy is 1/10,000.

NOTE: This property is not located within a flood hazard area.

Survey by: Richard D. Wooten, Jr.
Greenville, South Carolina

SOUTH CAROLINA
RICHARD D. WOOTEN, JR.
4678

3.00CI

2 AP 19 84

S. C. R. L. S. No. 4678

Dwg. No. 3354