


FILED
GREENVILLE CO. S.C.
APR 20 4 45 PM '84
R.M.C.

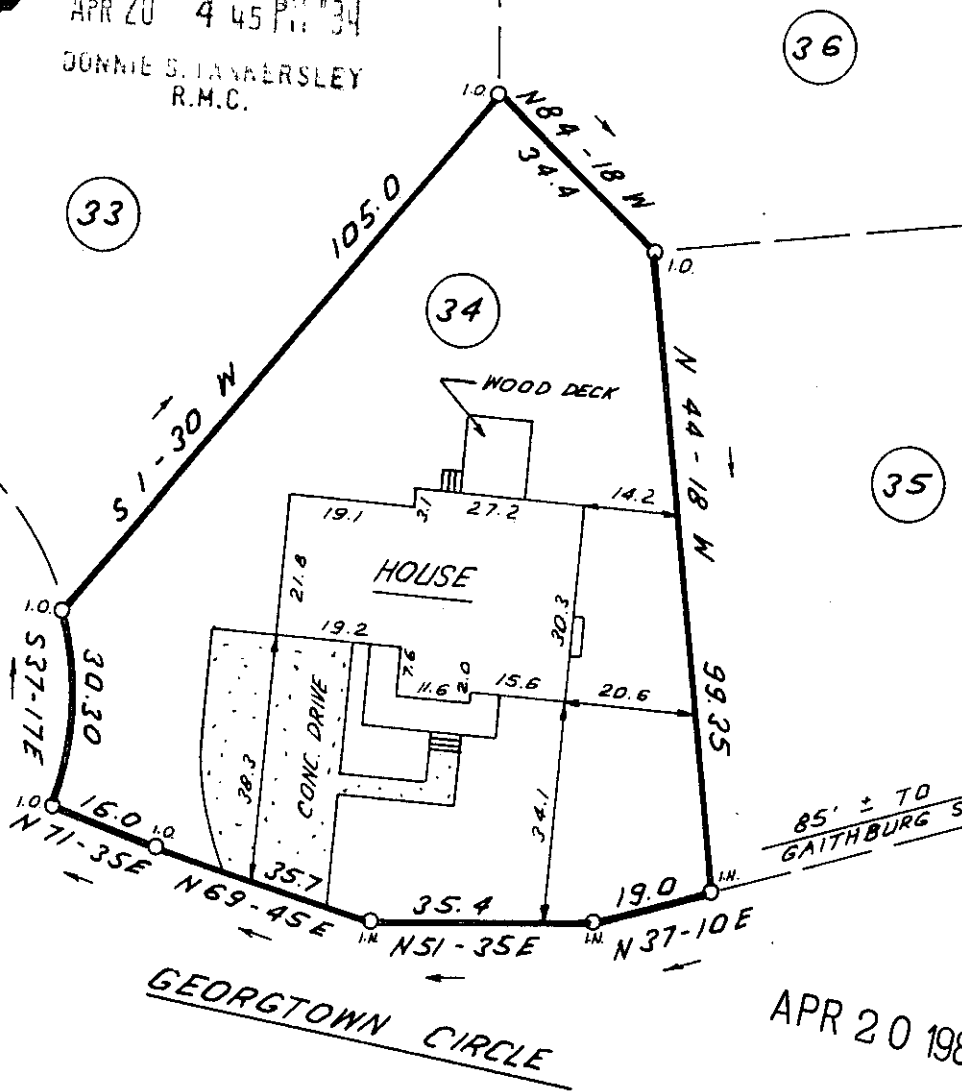

85' ± TO
GAITHBURG SQUARE

GEORGTOWN CIRCLE

APR 20 1984

10-0-31
✓ 32936



THIS IS TO CERTIFY THAT THE PROPERTY SHOWN ON THIS PLAT WAS SURVEYED UNDER MY DIRECT SUPERVISION. PROPERTY LINES AND IMPROVEMENTS SHOWN ARE LOCATED CORRECTLY AND THAT NO VISIBLE ENCROACHMENTS EXIST UNLESS OTHERWISE SHOWN. THIS PROPERTY IS NOT LOCATED IN A DESIGNATED FLOOD HAZARD AREA.



RLS: JAMES R. FREELAND
NO: 4781

STATE OF SOUTH CAROLINA
GREENVILLE COUNTY

EASTGATE VILLAGE
LOT 34
PROPERTY OF
GERALD K. OWENS

LECTO ----- 3 AP 20 84

FREELAND & ASSOCIATES
Engineers • Land Surveyors
318 WEST STONE AVENUE.
GREENVILLE, S.C.
(803) 271-4924

PLAT BOOK	4X - 31
DEED BOOK	1138 - 521
TAX MAP	538.13-1-34
PARTY CHIEF	J.E.C.
DRAWN	B.R.
DATE	4-18-84
SWG NO	10928.000D