


JOHN SCHRAMM

FILED  
 GREENVILLE CO. S. C.  
 APR 26 12 54 PM '84  
 BONNIE S. TALKERSLEY  
 R.M.C.

Note:  
 Improvements on this  
 lot are not in a flood  
 hazard area.

APR 26 1984  
 33547

PROPERTY OF  
 JOEL M. LUNSFORD & ALISON C. LUNSFORD  
 NEAR GREEN, GREENVILLE COUNTY, S. C.  
 9 APR 1984

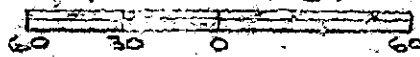

10-0-65

This is to certify that on the 9th day of April, 1984, I surveyed the property shown on this plot, being known as 1.22 acres on plat of PROPERTY OF CHARLES M. HAWS AND EVELYN M. HAWS and recorded in the REC Office Greenville County, S. C., in Plat Book "5 - N" at Page 125 and also being known as PROPERTY OF JOEL M. LUNSFORD & ALISON C. LUNSFORD and recorded in Plat Book \_\_\_\_\_ at Page \_\_\_\_\_; and that the property lines, walls and buildings are as shown hereon, and that the walls and buildings located on said lot do not encroach or project on adjacent street or property, and that no adjacent walls or buildings encroach or project on said premises, and no power lines cross this property except as shown hereon.

CAROLINA SURVEYING CO.  
 112 Manly St.  
 Greenville, S. C.

R. B. Briley  
 R. B. Briley, REC 7/19/84  
 Recordable Plat