

BRUSHY CREEK ROAD

PROPERTY OF
RIDDLE BROTHERS & WEST BUILDERS INC.

Located approx. 3 miles West of Greer
 GREENVILLE COUNTY, SOUTH CAROLINA

SCALE: 1" = 50 FEET APRIL 12, 1984




This is to certify that on April 12, 1984, I surveyed the property shown on this plat, and the same is correct, and that the property lines, walls and building shown thereon on the above plat, do not encroach or project on adjacent streets or property, and that no adjacent buildings or walls encroach or project on said premises. This property is not located in a Flood Plane.

33551 ✓
John A. Simmons

Registered Surveyor in S.C. #2212

FILED
 GREENVILLE CO. S.C.
 APR 26 4 12 PM '84
 DONNIE STANKERSLE
 R.M.C.

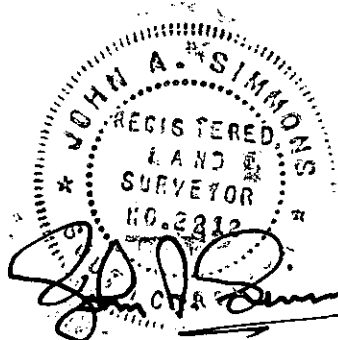

APR 26

Tri-State Surveyors
 109 Few Street
 Greer, S. C. 29651

10-0-67

GCTO -- 1 AP2684 750 3.00CI