MICROFILMED

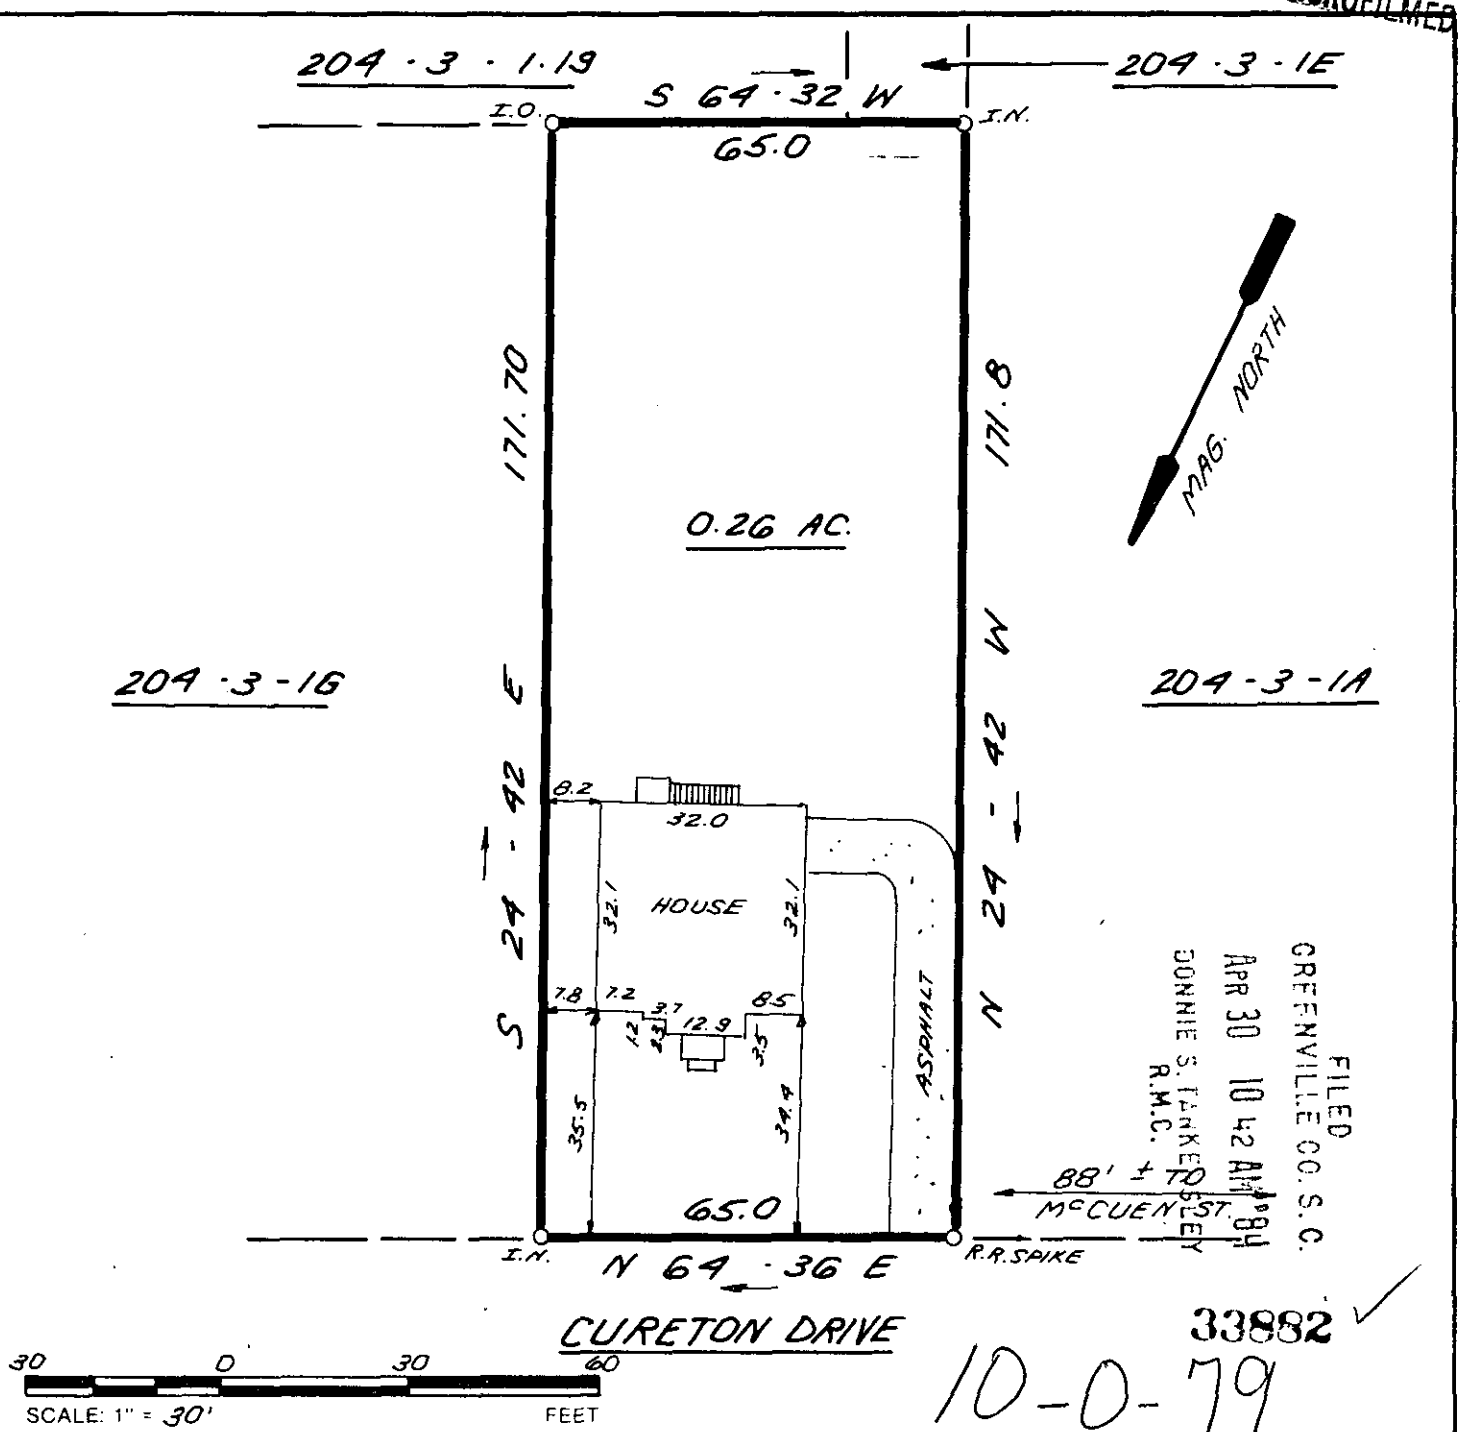

FILED
GREENVILLE CO. S.C.
APR 30 10 42 AM '84
DONNIE S. TANKERSLEY
R.M.C.

33882

10-0-79

THIS IS TO CERTIFY THAT THE PROPERTY SHOWN ON THIS PLAT WAS SURVEYED UNDER MY DIRECT SUPERVISION. PROPERTY LINES AND IMPROVEMENTS SHOWN ARE LOCATED CORRECTLY AND THAT NO VISIBLE ENCROACHMENTS EXIST UNLESS OTHERWISE SHOWN. THIS PROPERTY IS NOT LOCATED IN A DESIGNATED FLOOD HAZARD AREA

SOUTH CAROLINA REGISTERED LAND SURVEYOR 4781 JAMES R. FREELAND

RLS: JAMES R. FREELAND
NO: 4781

STATE OF SOUTH CAROLINA
GREENVILLE COUNTY

SURVEY FOR

J. GRADY MILLER, III

FREELAND & ASSOCIATES
Engineers • Land Surveyors
318 WEST STONE AVENUE.
GREENVILLE, S.C.
(803) 271-4924

PLAT BOOK	
DEED BOOK	
TAX MAP	204-3-5
PARTY CHIEF	B.C.
DRAWN	K.E.G.
DATE	4/27/84
DWG NO.	10997

THE PRINT MACHINE, INC. NS7703

SCTC --2 AP30 84 020 7.00