

N/F ROSE M. CUNNINGHAM ET. AL.


FILED GREENVILLE CO. S. C.

N 64 - 35 E

APR 30 4 24 PM '84

PROPERTY LINE

DONNIE S. TANKERSLEY R.M.C.

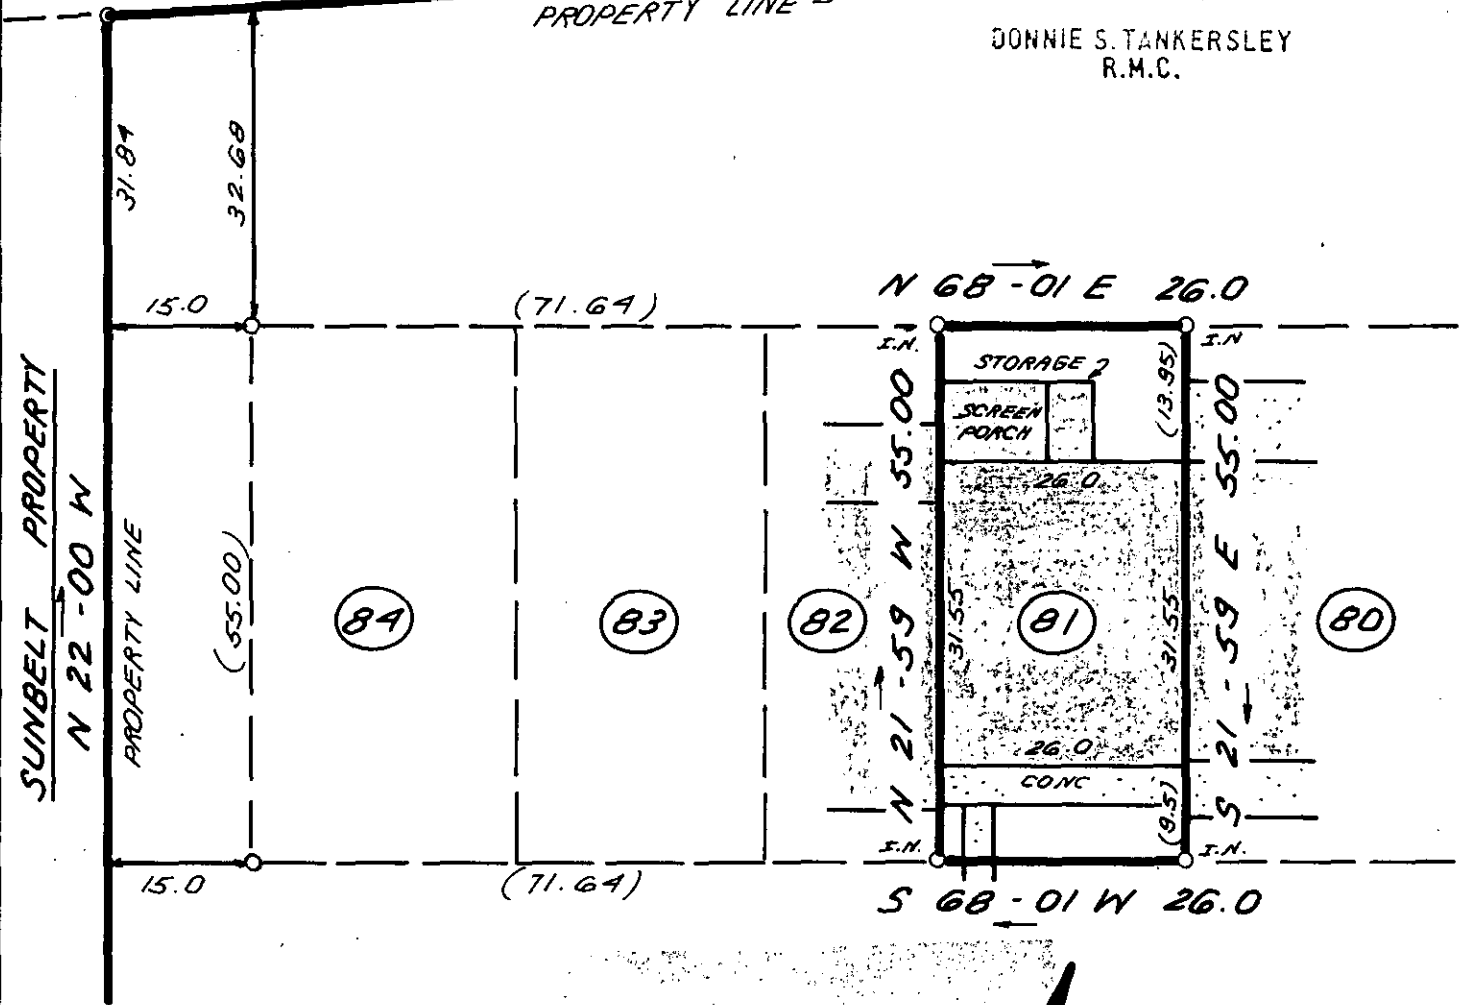

APR 30 1984  
 1  
 10-0-82  
 ✓ 33982

THIS IS TO CERTIFY THAT THE PROPERTY SHOWN ON THIS PLAT WAS SURVEYED UNDER MY DIRECT SUPERVISION. PROPERTY LINES AND IMPROVEMENTS SHOWN ARE LOCATED CORRECTLY AND THAT NO VISIBLE ENCROACHMENTS EXIST UNLESS OTHERWISE SHOWN. THIS PROPERTY IS NOT LOCATED IN A DESIGNATED FLOOD HAZARD AREA.

SOUTH CAROLINA REGISTERED LAND SURVEYOR  
 4781  
 JAMES R. FREELAND  
 RLS: JAMES R. FREELAND  
 NO: 4781

STATE OF SOUTH CAROLINA  
 GREENVILLE COUNTY

JAMESTOWNE II  
UNIT 81  
 PROPERTY OF  
BILLY G. HARAKAS  
MARIA M. HARAKAS

FREELAND & ASSOCIATES  
 Engineers • Land Surveyors  
 318 WEST STONE AVENUE.  
 GREENVILLE, S.C.  
 (803) 271-4924

PLAT BOOK	3W-33
DEED BOOK	
TAX MAP	
PARTY CHIEF	B.H.
DRAWN	K.E.G.
DATE	4/27/84
DWG. NO.	10387

SC10 2 APR 30 84 093 3.0001