


Note:
Improvements on this lot are not in a flood hazard area.

PROPERTY OF
MELVIN E. PORTER JR. & SARAH L. PORTER
NEAR GREENVILLE, GREENVILLE COUNTY, S.C.
30 APR 1984

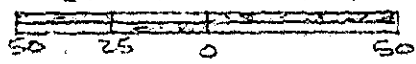

This is to certify that on the 30th day of April, 1984, I surveyed the property shown on this plat, being known as lot 7 (1.04 acres) on plat of ADDITION TO CHEROKEE FOREST recorded in REC. Office Greenville County, S. C., in Plat Book " RR " at Page 141 and also known as PROPERTY OF MELVIN E. PORTER, JR. & SARAH LEE PORTER and recorded in Plat Book _____ at Page _____ ; and that the property lines, walls and buildings are as shown hereon, and that the walls and buildings located on said lot do not encroach or project on adjacent street or property, and that no adjacent walls or buildings encroach or project on said premises, and no power lines cross this property, except as shown hereon.

FILED
GREENVILLE CO. S.C.
May 1 2 38 PM '84
DONNIE S. TANKERSLEY
R.M.C.

10-0-87 34200 ✓

R. B. Bruce
R. B. Bruce, RLS # 1952
SOUTH CAROLINA REGISTERED PROFESSIONAL SURVEYOR

CAROLINA SURVEYING CO.
112 Manly St.
Greenville, S.C. 29601-84

Recordable Plat
088 3.00 CD