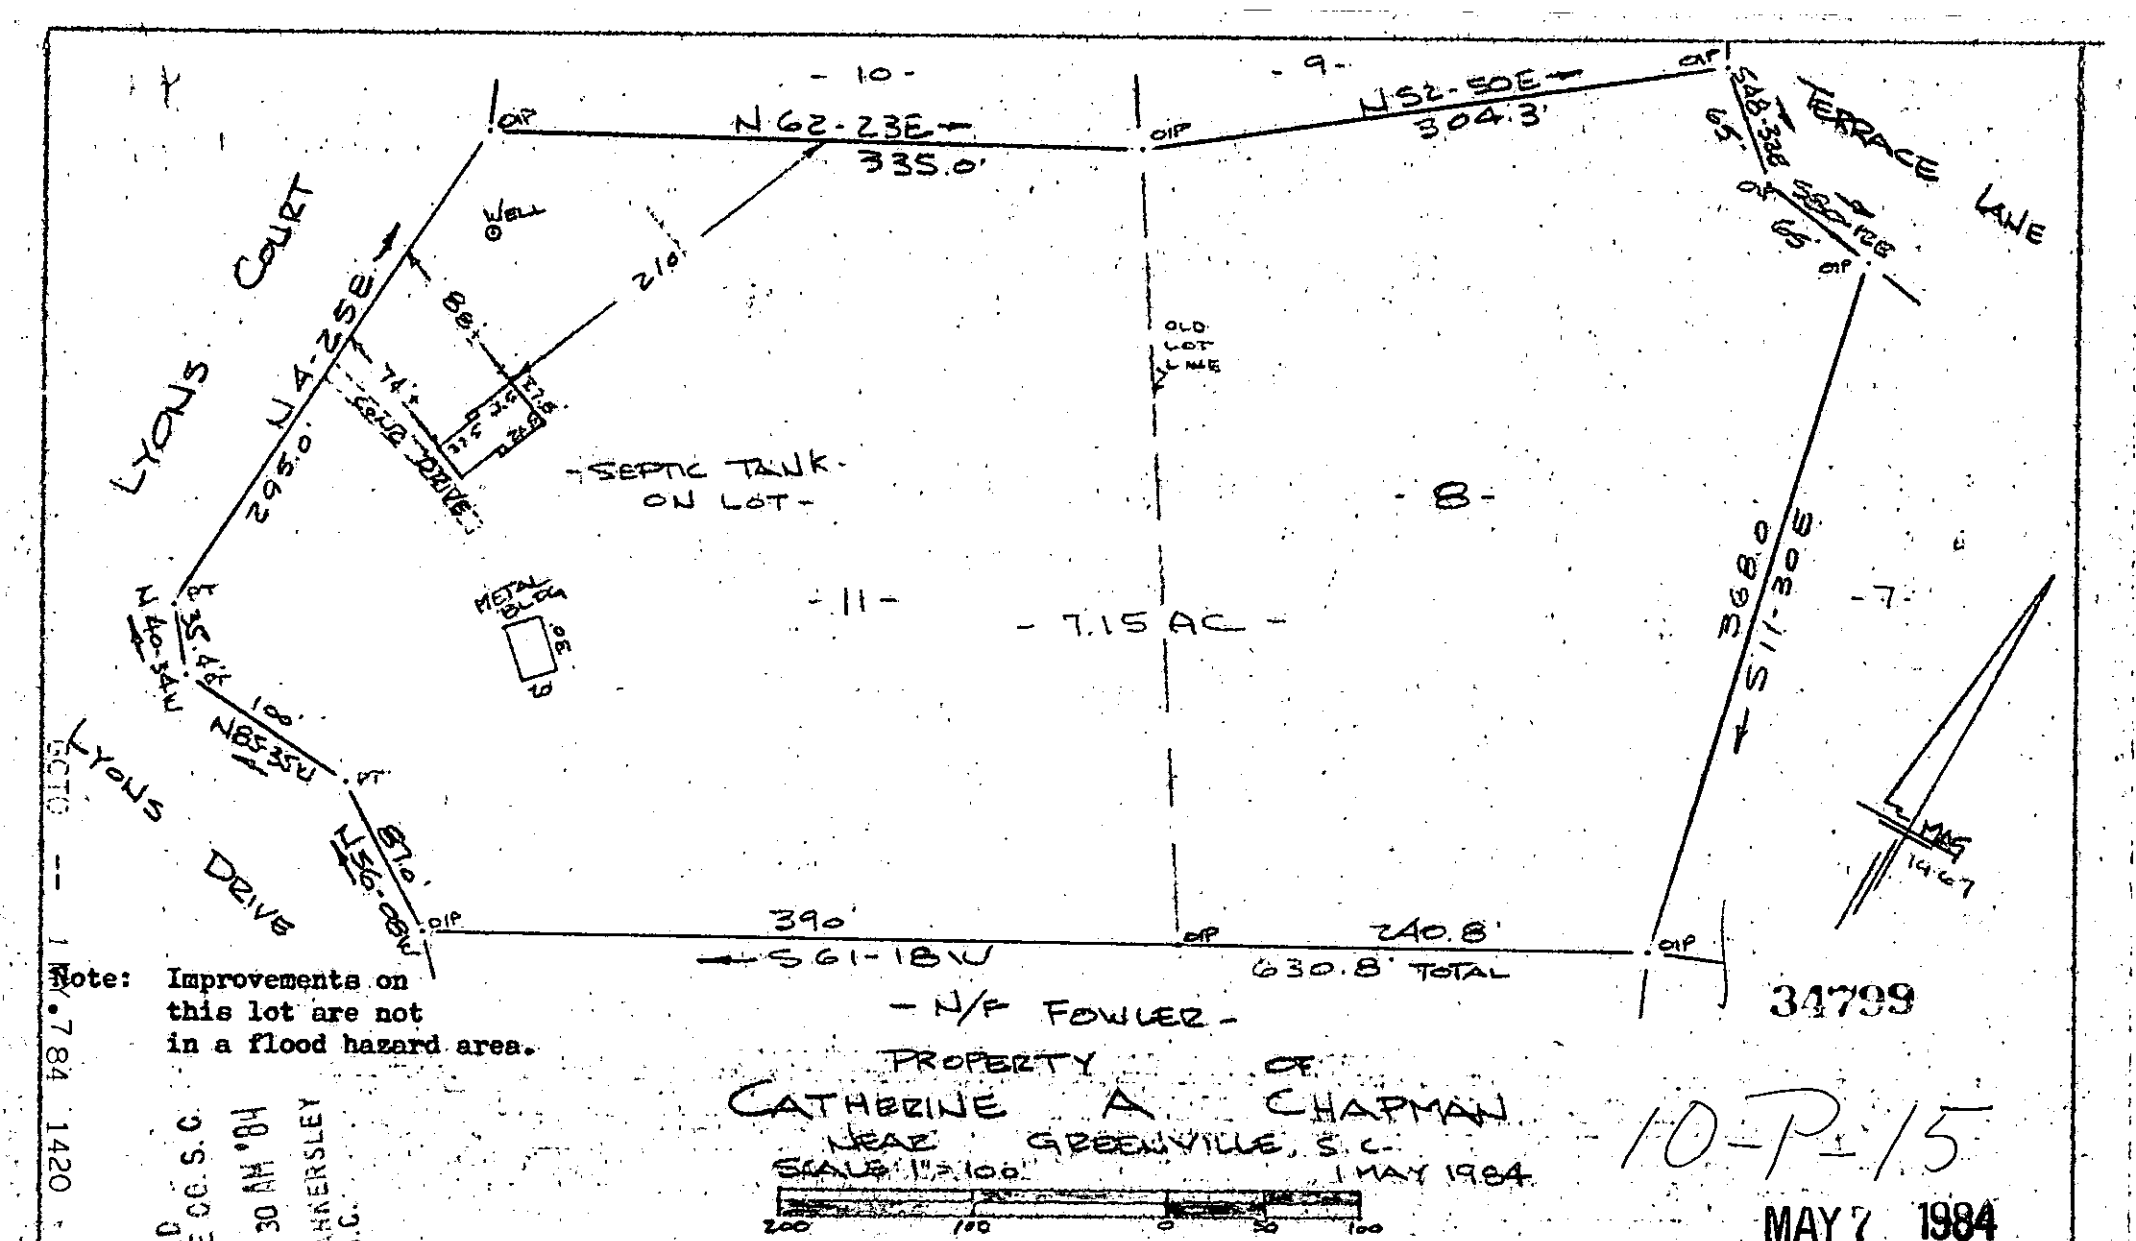

Note: Improvements on this lot are not in a flood hazard area.

34799

PROPERTY OF
CATHERINE A. CHAPMAN
NEAR GREENVILLE, S. C.
SCALE 1" = 100'
1 MAY 1984

10-P-15

MAY 7 1984

This is to certify that on the 1st day of May, 1984, I surveyed the property shown on this plat, being known as lots 8 & 11 (7.15 acres) on plat of TERRACE ACRES and recorded in the RMC Office Greenville County, S. C., in Plat Book " 000 " at Page 126; and that the property lines, walls and buildings are as shown hereon, and that the walls and buildings located on said lot do not encroach or project on adjacent street or property, and that no adjacent walls or buildings encroach or project on said premises, and no power lines cross this property except as shown hereon.

CAROLINA SURVEYING CO.
112 Manly St.
Greenville, S. C.

Recordable Plat

R. B. Bruce, RLS #1952

FILED
GREENVILLE CO. S. C.
30 AM '84
DONNIE S. TANNERSLEY
R.M.C.

STATE OF SOUTH CAROLINA
REGISTERED
R. B. BRUCE
LAND SURVEYOR

MICROFILMED

559.4-1-8&11