

FILED  
 GREENVILLE CO. S.C.  
 MAY 22 11 15 AM '84  
 DONNIE S. TANKERSLEY  
 R.M.C.

HOLLAND ROAD

MAY 22 1984

10-P-81 ✓ 36732



THIS IS TO CERTIFY THAT THE PROPERTY SHOWN ON THIS PLAT WAS SURVEYED UNDER MY DIRECT SUPERVISION. PROPERTY LINES AND IMPROVEMENTS SHOWN ARE LOCATED CORRECTLY AND THAT NO VISIBLE ENCROACHMENTS EXIST UNLESS OTHERWISE SHOWN. THIS PROPERTY IS NOT LOCATED IN A DESIGNATED FLOOD HAZARD AREA.


300 8  
21801

**STATE OF SOUTH CAROLINA  
 GREENVILLE COUNTY**

**FREELAND & ASSOCIATES**  
 Engineers • Land Surveyors  
 318 WEST STONE AVENUE,  
 GREENVILLE, S.C.  
 (803) 271-4924

GILDER CREEK  
PHASE I; LOT 20  
PROPERTY OF  
DAVID E. TINGA &  
DONNA K. TINGA

PLAT BOOK
DEED BOOK
TAX MAP
PARTY CHIEF J.C.
DRAWN B.R.
DATE 5-15-84
DWG. NO. 11086

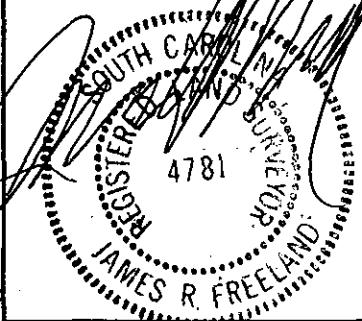

RLS: JAMES R. FREELAND  
 NO: 4781