


WILLIAMS

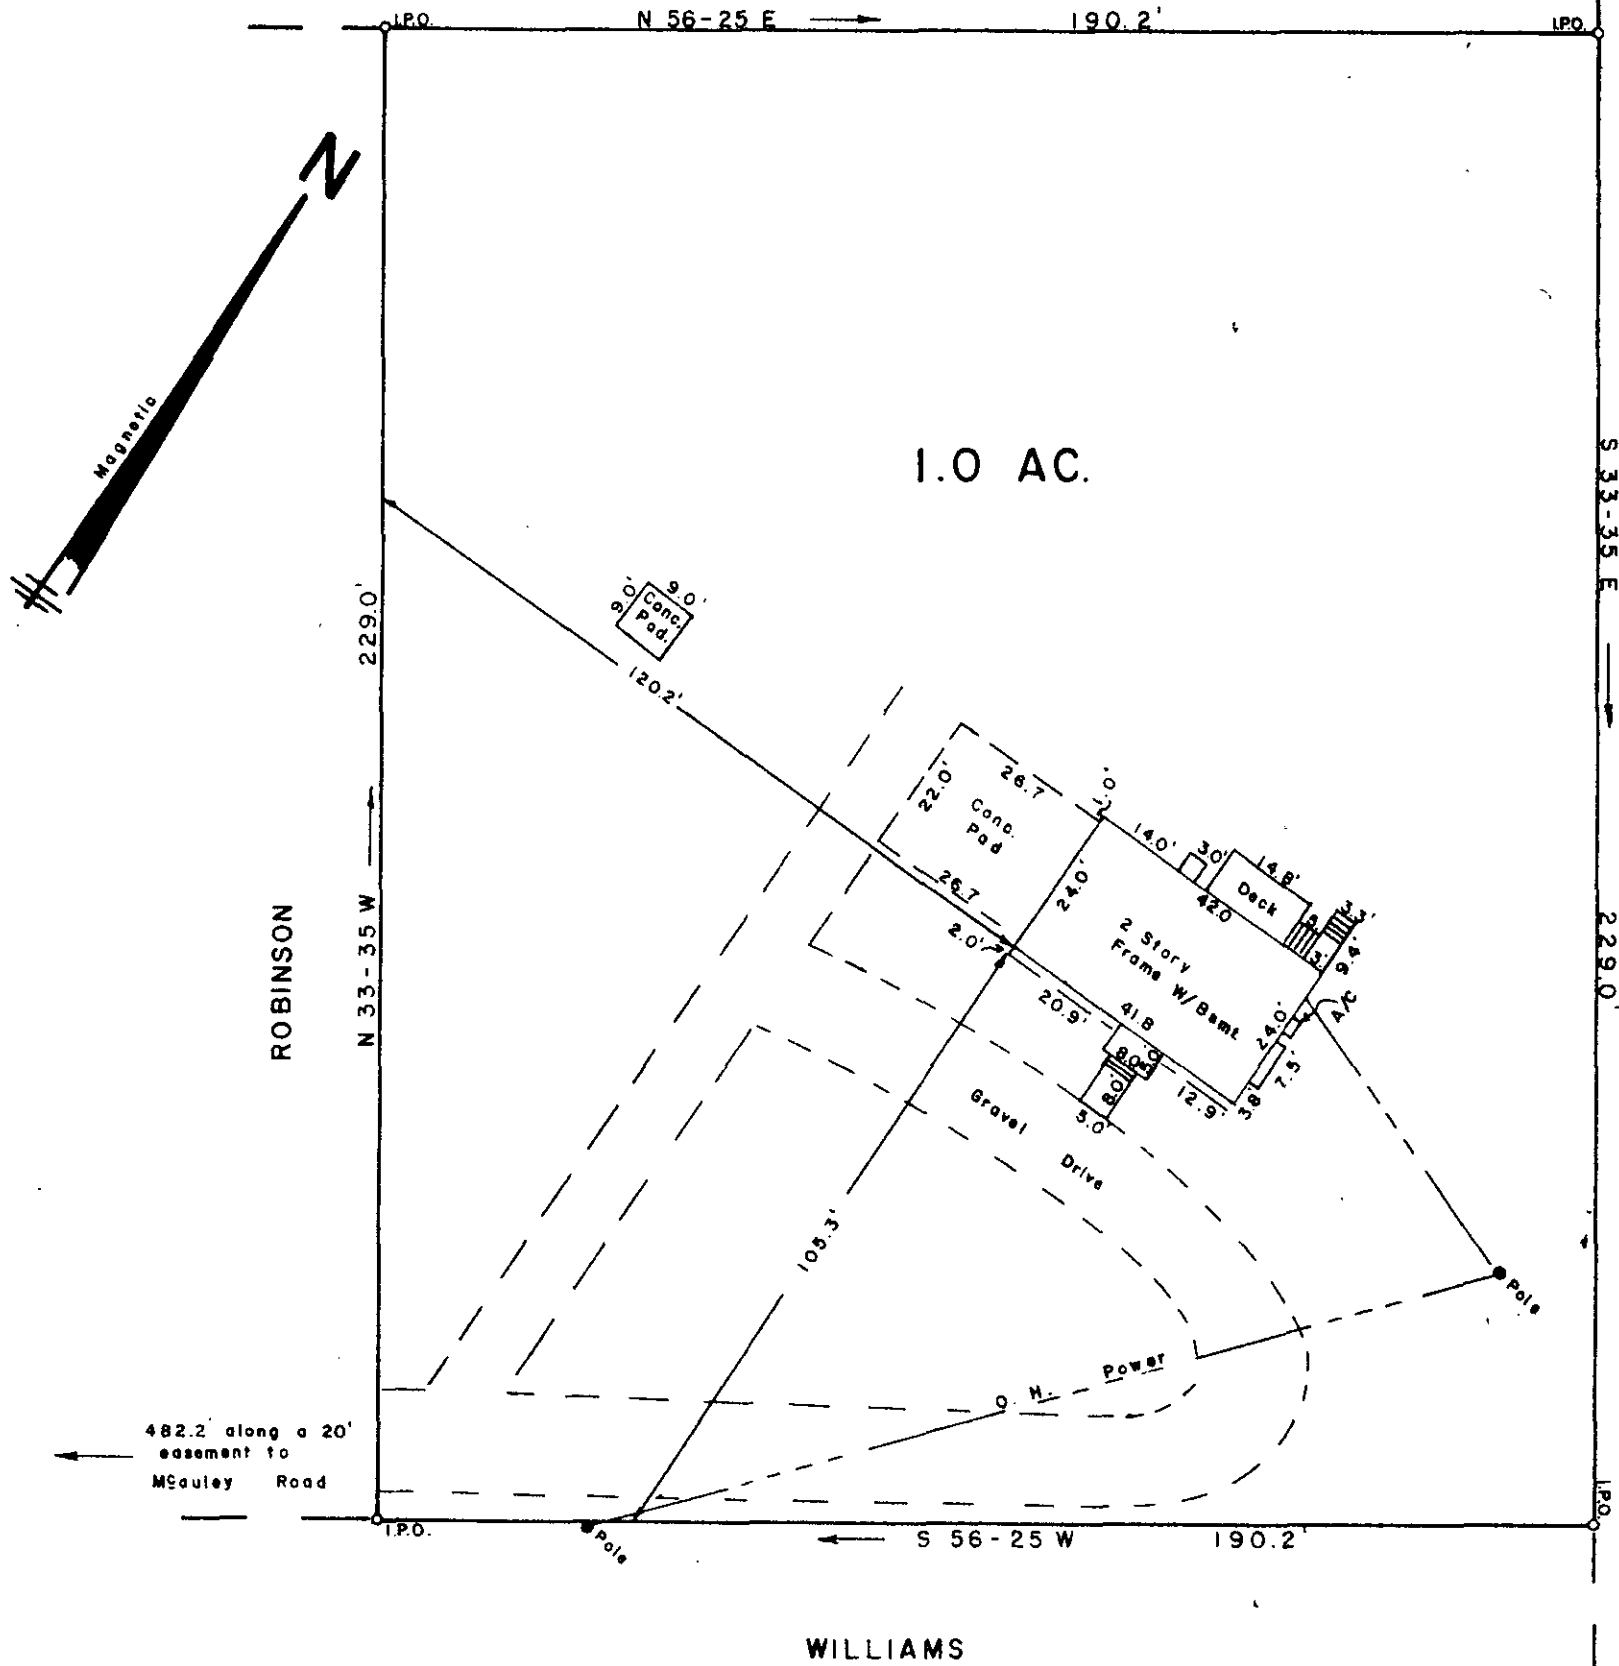

SURVEY FOR
EDWARD M. ROBINSON
ANGELA RENE ROBINSON
 NEAR TRAVELERS REST GREENVILLE COUNTY

SOUTH CAROLINA

JUNE 20, 1984

49853

10-0-77

JUN 26 1984

I hereby certify that the measurements as shown above are correct and there are no encroachments or projections other than shown.

I hereby certify that the ratio of precision of the field survey is 1/5000 as shown hereon and the area was determined by computer.

Jeffery M. Plumblee
 JEFFERY M. PLUMBLEE
 LAND SURVEYOR
 S.C. # 7881

JEFFERY M. PLUMBLEE, INC.
 LAND SURVEYING

P O BOX 788
 TRAVELERS REST, S C 29690

(803) 834-4428

FILED
 GREENVILLE CO. S.C.
 JUN 26 10 21 AM '84
 DONNIE S. TARKERLEY
 R.M.C.

