MICROFILMED

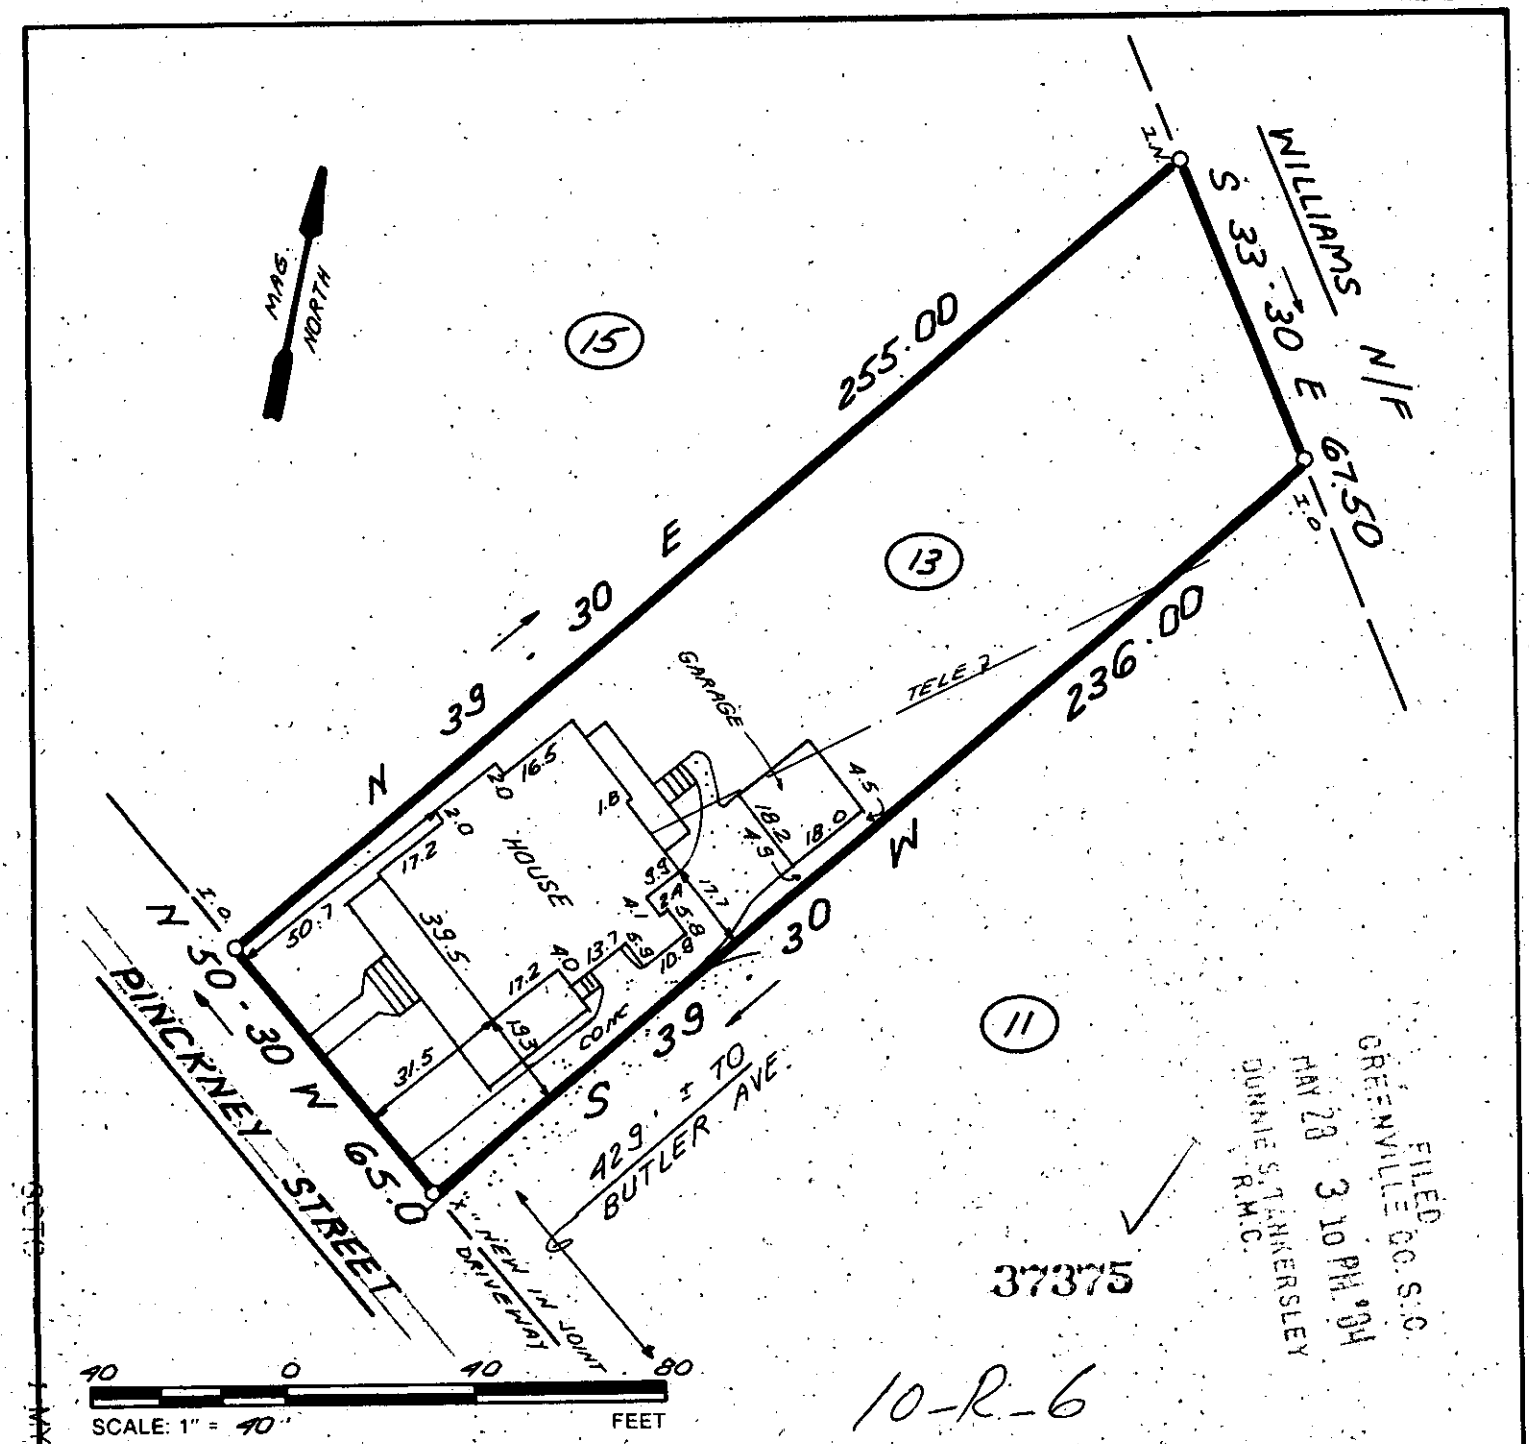

FILED
GREENVILLE CO. S.C.
MAY 28 3 10 PM '84
DORRIE S. TANKERSLEY
R.M.C.

37375

10-R-6

THIS IS TO CERTIFY THAT THE PROPERTY SHOWN ON THIS PLAT WAS SURVEYED UNDER MY DIRECT SUPERVISION. PROPERTY LINES AND IMPROVEMENTS SHOWN ARE LOCATED CORRECTLY AND THAT NO VISIBLE ENCROACHMENTS EXIST UNLESS OTHERWISE SHOWN. THIS PROPERTY IS NOT LOCATED IN A DESIGNATED FLOOD HAZARD AREA.

SOUTH CAROLINA REGISTERED LAND SURVEYOR 4781

RLS: JAMES A. FREELAND
NO: 4781

STATE OF SOUTH CAROLINA
GREENVILLE COUNTY

"HOME PLACE OF W.P McBEE"
LOT 13
PROPERTY OF
RONALD M. WHITWORTH
COLLEEN M. WHITWORTH

FREELAND & ASSOCIATES
Engineers • Land Surveyors
318 WEST STONE AVENUE
GREENVILLE, S.C.
(803) 271-4924

PLAT BOOK	A - 83
DEED BOOK	1104-269 & 1186-503
TAX MAP	19-1-20 & 20.1
PARTY CHIEF	B.G.
DRAWN	K.E.G.
DATE	5/21/84
DWG. NO.	11,118

THE PRINT MACHINE, INC. N37703