

HUGHES  
N/F

CARVER

N/F

FILED  
GREENVILLE CO. S.C.  
MAY 29 2 44 PM '84  
DORRIS S. TANKERSLEY  
S.M.C.



CLARENDON AVENUE


260.75' ± TO  
CIRCLE ST.

10-R-15 ✓ 37512

MAY 29 1984

THIS IS TO CERTIFY THAT THE PROPERTY SHOWN ON THIS PLAT WAS SURVEYED UNDER MY DIRECT SUPERVISION. PROPERTY LINES AND IMPROVEMENTS SHOWN ARE LOCATED CORRECTLY AND THAT NO VISIBLE ENCROACHMENTS EXIST UNLESS OTHERWISE SHOWN. THIS PROPERTY IS NOT LOCATED IN A DESIGNATED FLOOD HAZARD AREA.

300 8 21801

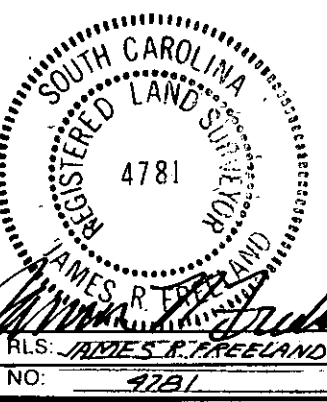

STATE OF SOUTH CAROLINA  
GREENVILLE COUNTY

FREELAND & ASSOCIATES  
Engineers • Land Surveyors  
318 WEST STONE AVENUE.  
GREENVILLE, S.C.  
(803) 271-4924

SURVEY FOR  
DAVID N. MILLER  
ANDREA MILLER

PLAT BOOK	
DEED BOOK	1191-185
TAX MAP	163-2-27
PARTY CHIEF	L.T.
DRAWN	K.E.G.
DATE	5/29/84
DWG. NO.	11-139