



FILED
GREENVILLE CO. S.C.
MAY 29 4 44 PM '84
DUNNIE S. WATKINS
R.M.C.

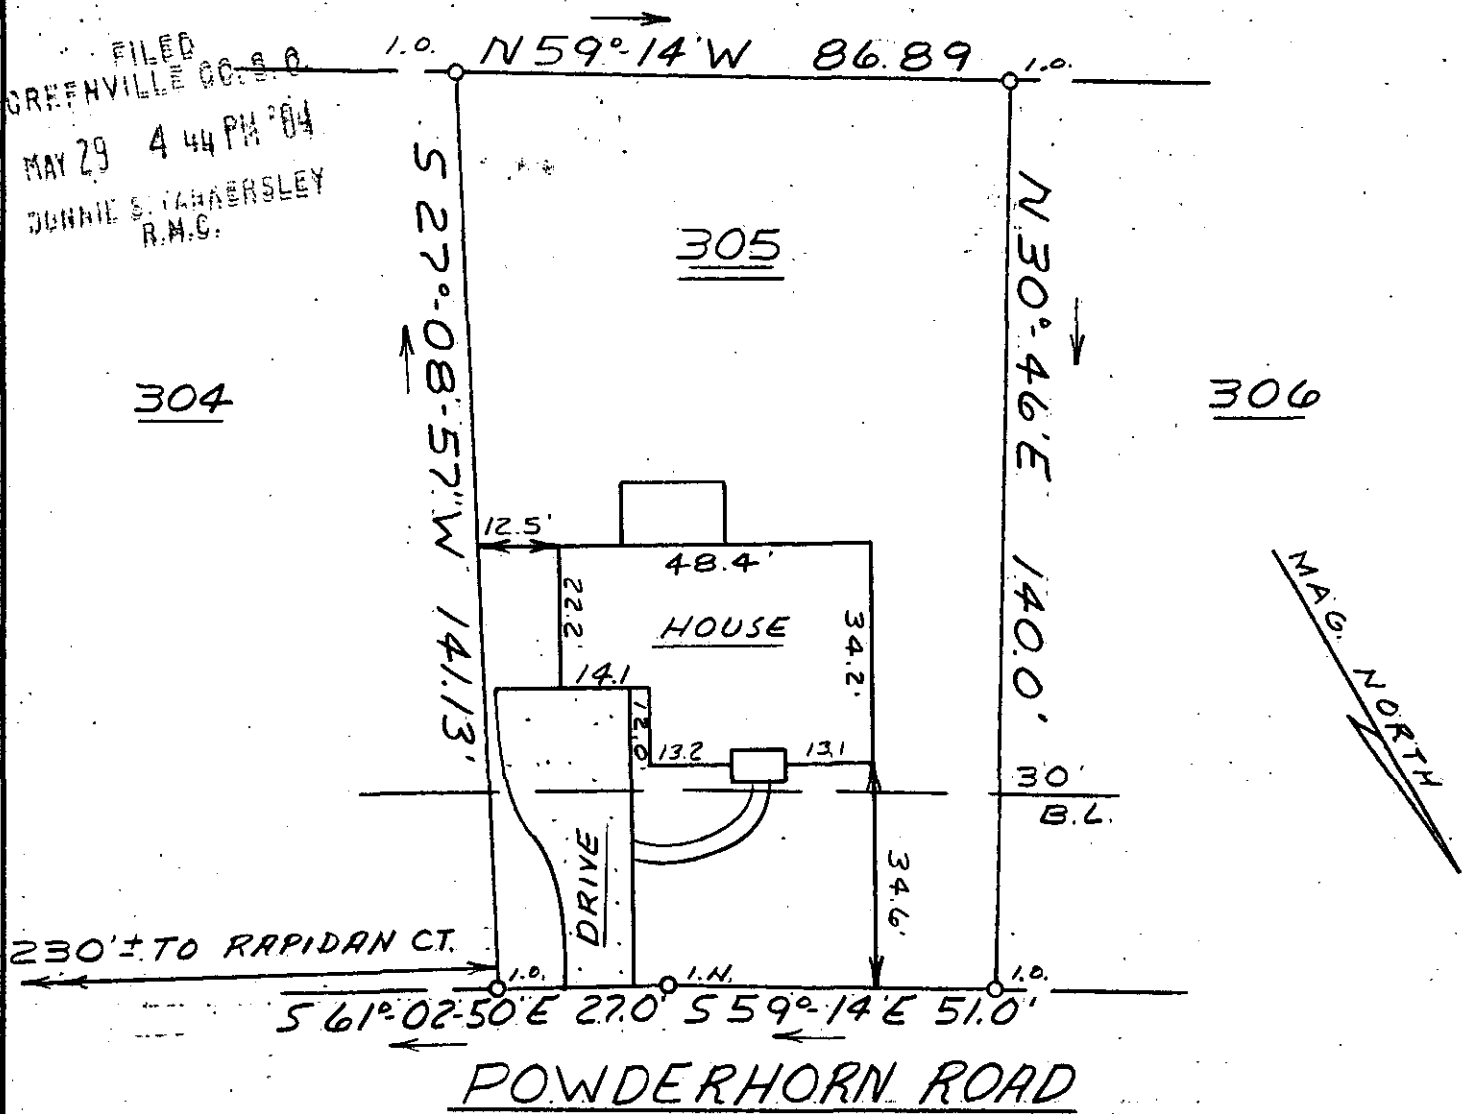

Drainage & utilities easement 5' each side of all side and rear lot lines.

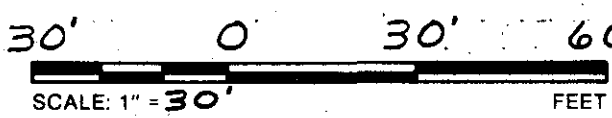

MAY 29 1984

10-R-16 37537 56A

THIS IS TO CERTIFY THAT THE PROPERTY SHOWN ON THIS PLAT WAS SURVEYED UNDER MY DIRECT SUPERVISION. PROPERTY LINES AND IMPROVEMENTS SHOWN ARE LOCATED CORRECTLY AND THAT NO VISIBLE ENCROACHMENTS EXIST UNLESS OTHERWISE SHOWN. THIS PROPERTY IS NOT LOCATED IN A DESIGNATED FLOOD HAZARD AREA.

SOUTH CAROLINA
REGISTERED LAND SURVEYOR
4781
JAMES R. FREELAND

RLS: JAMES R. FREELAND
NO: 4781

STATE OF SOUTH CAROLINA
GREENVILLE COUNTY

POWDERHORN
MAP 1 - SEC. 4 - LOT 305
PROPERTY OF
MARC H. JACOBSON &
HEIDI P. JACOBSON

MAY 29 1984

FREELAND & ASSOCIATES
Engineers • Land Surveyors
318 WEST STONE AVENUE
GREENVILLE, S.C.
(803) 271-4924

PLAT BOOK 8P-22
DEED BOOK
TAX MAP 323-1-204
PARTY CHIEF J.E.C.
DRAWN M.L.C.
DATE 5-29-84
DWG. NO. 84-P-1774