

FILED  
GREENVILLE CO. S.C. 44  
MAY 31 10 57 AM '84  
DONNIE S. JAMMERSLEY  
R.M.C.



65

N 46-03 E 60.0

72

350.0


350.0

66

N 41-45 W

S 41-45 E

67

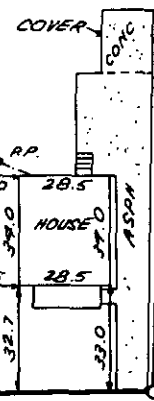

MAY 31 1984

S 46-03 W 60.0

37814

FRANKLIN ROAD




10R-29

THIS IS TO CERTIFY THAT THE PROPERTY SHOWN ON THIS PLAT WAS SURVEYED UNDER MY DIRECT SUPERVISION. PROPERTY LINES AND IMPROVEMENTS SHOWN ARE LOCATED CORRECTLY AND THAT NO VISIBLE ENCROACHMENTS EXIST UNLESS OTHERWISE SHOWN. THIS PROPERTY IS NOT LOCATED IN A DESIGNATED FLOOD HAZARD AREA.

2 MY 31 84 1411 3.000

STATE OF SOUTH CAROLINA  
GREENVILLE COUNTY

FREELAND & ASSOCIATES  
Engineers • Land Surveyors  
318 WEST STONE AVENUE.  
GREENVILLE, S.C.  
(803) 271-4924

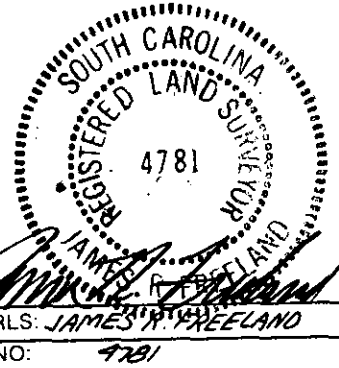

COLONIA COMPANY ET. AL.  
LOT 66  
PROPERTY OF  
DALE HAMMOND  
KIM LISTER

|             |              |
|-------------|--------------|
| PLAT BOOK   | G - 112      |
| DEED BOOK   | 1143 - 506   |
| TAX MAP     | 156-6-13     |
| PARTY CHIEF | J.C.         |
| DRAWN       | K.E.G.       |
| DATE        | MAY 25, 1984 |
| DWG. NO.    | 11,161       |