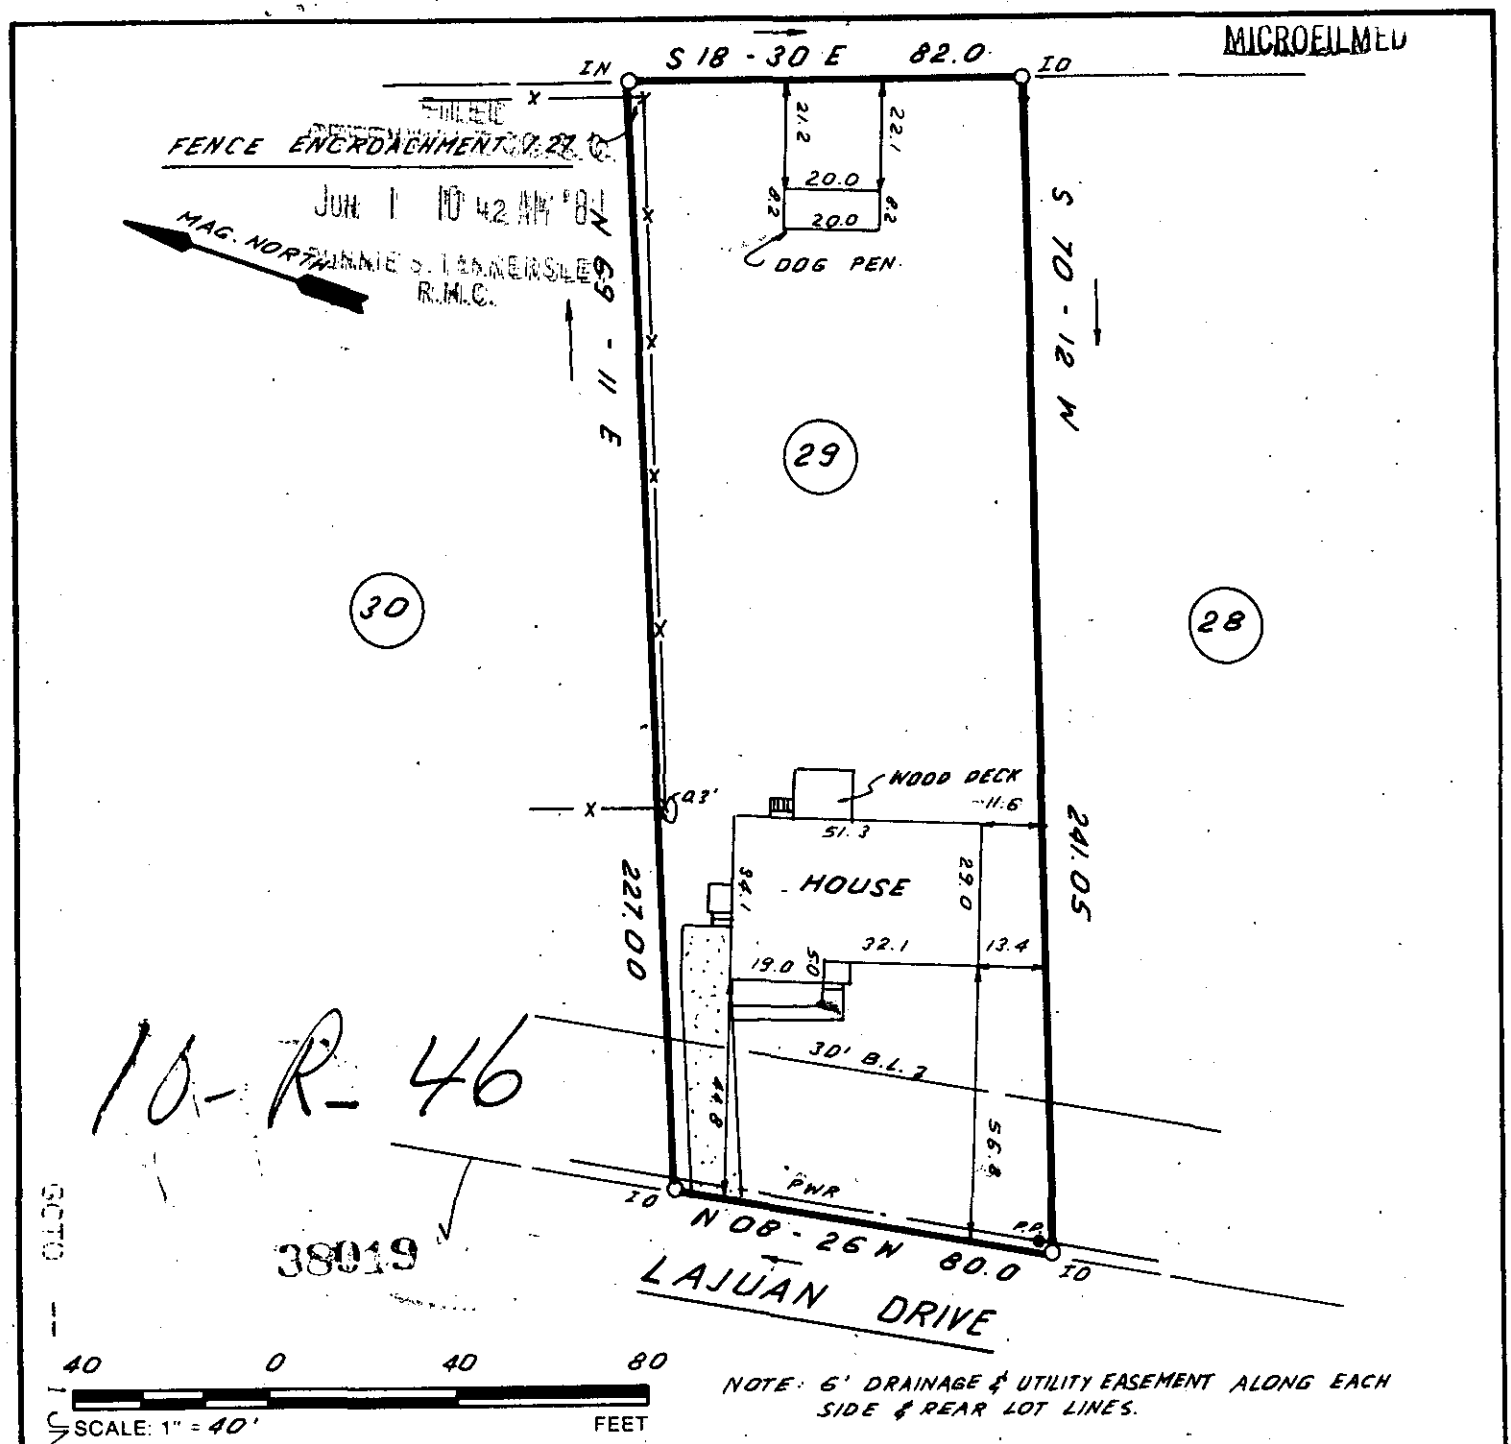

NOTE: 6' DRAINAGE & UTILITY EASEMENT ALONG EACH SIDE & REAR LOT LINES.

THIS IS TO CERTIFY THAT THE PROPERTY SHOWN ON THIS PLAT WAS SURVEYED UNDER MY DIRECT SUPERVISION. PROPERTY LINES AND IMPROVEMENTS SHOWN ARE LOCATED CORRECTLY AND THAT NO VISIBLE ENCROACHMENTS EXIST UNLESS OTHERWISE SHOW. THIS PROPERTY IS NOT LOCATED IN A DESIGNATED FLOOD HAZARD AREA.

SOUTH CAROLINA REGISTERED LAND SURVEYOR 4781 JAMES R. FREELAND

RLS: JAMES R. FREELAND
NO. 4781

STATE OF SOUTH CAROLINA
GREENVILLE COUNTY

STRATFORD
SEC. 2; LOT 29
PROPERTY OF
RONALD A. WILSON
RETHA J. WILSON

FREELAND & ASSOCIATES
Engineers • Land Surveyors
318 WEST STONE AVENUE.
GREENVILLE, S.C.
(803) 271-4924

PLAT BOOK	5D - 90
DEED BOOK	1130 - 275
TAX MAP	B 15 - 2 - 221
PARTY CHIEF	R. J.
DRAWN	B. R.
DATE	6 - 1 - 84
DWG. NO.	11,215

THE PRINT MACHINE, INC. N37703