MICROFILMED

FILED
GREENVILLE CO. S.C.
JUN 5 10 47 AM '84
DONNIE S. TANKERSLEY
R.H.C.

DEL NORTE ESTATES ; SEC. IV

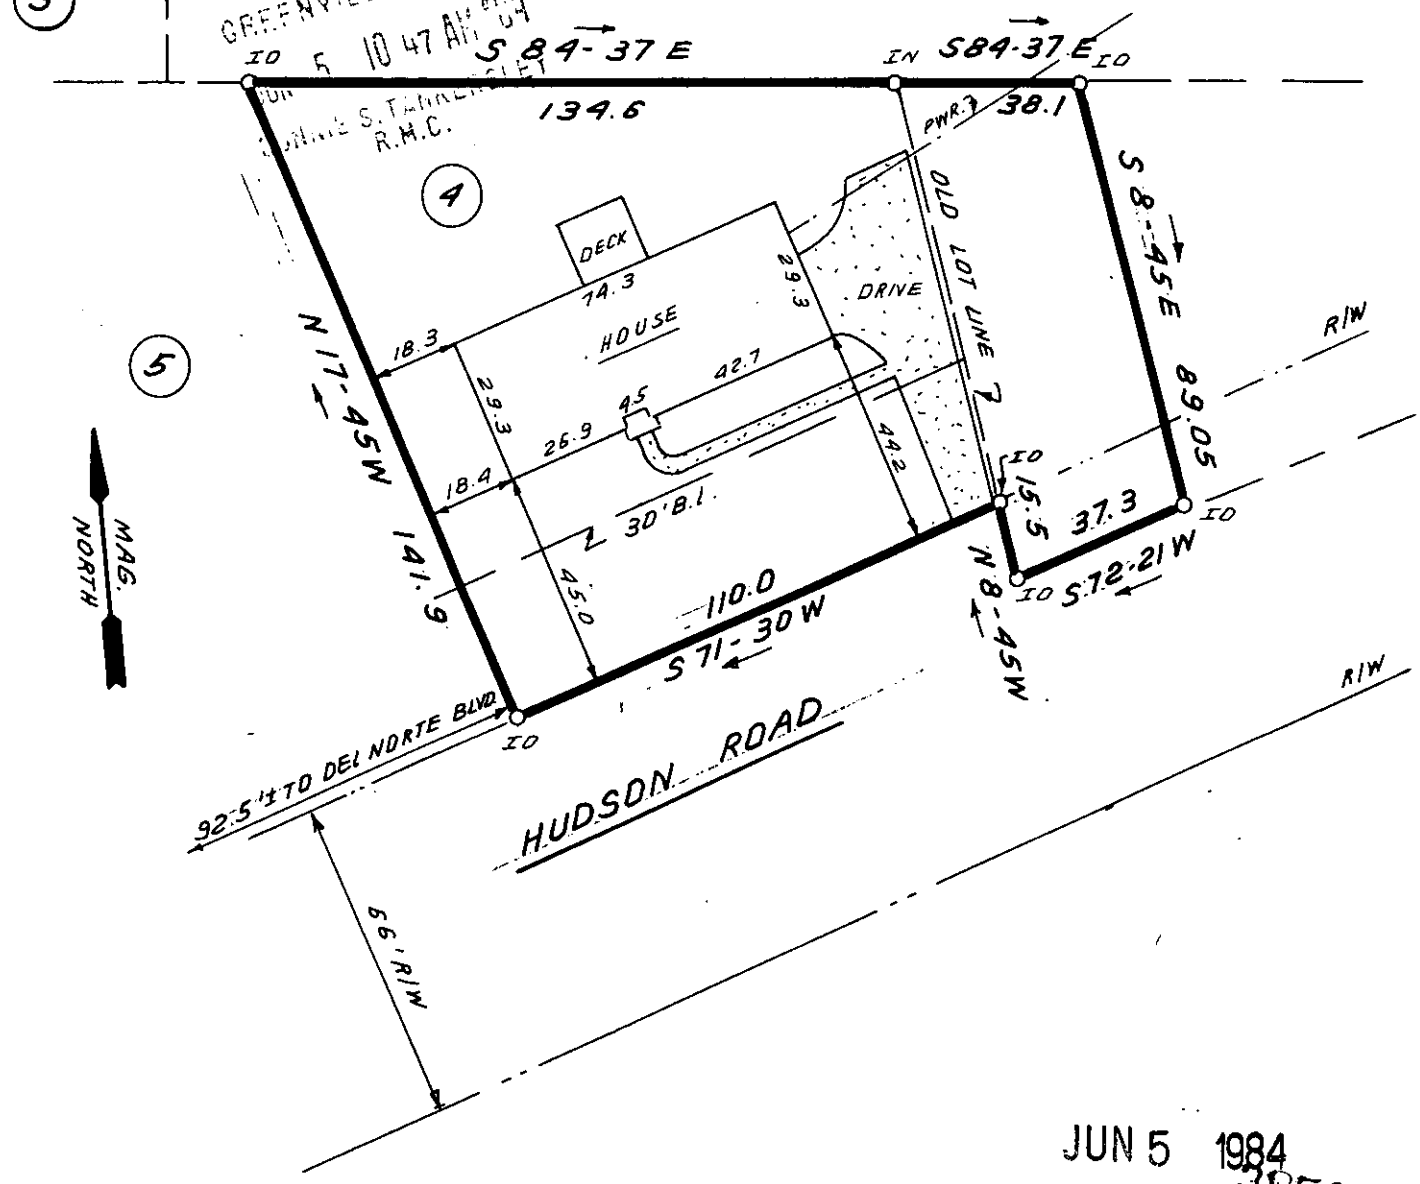

JUN 5 1984
38516

40 0 40 80
SCALE: 1" = 40 FEET

10R-66

THIS IS TO CERTIFY THAT THE PROPERTY SHOWN ON THIS PLAT WAS SURVEYED UNDER MY DIRECT SUPERVISION. PROPERTY LINES AND IMPROVEMENTS SHOWN ARE LOCATED CORRECTLY AND THAT NO VISIBLE ENCROACHMENTS EXIST UNLESS OTHERWISE SHOWN. THIS PROPERTY IS NOT LOCATED IN A DESIGNATED FLOOD HAZARD AREA.

SOUTH CAROLINA REGISTERED LAND SURVEYOR 4781 JAMES R. FREELAND

RLS: JAMES R. FREELAND
NO: 4781

STATE OF SOUTH CAROLINA
GREENVILLE COUNTY

DEL NORTE ESTATES
SEC. 4; LOT 4 & PT. LOT
PROPERTY OF
J. FRANK WILLIAMS, JR.
VICKI MELTON WILLIAMS

FREELAND & ASSOCIATES
Engineers • Land Surveyors
318 WEST STONE AVENUE.
GREENVILLE, S.C.
(803) 271-4924

PLAT BOOK	4N-8
DEED BOOK	1066-354
TAX MAP	538.9-1-159 & 182
PARTY CHIEF	R.J.
DRAWN	B.R.
DATE	JUNE 4. 84
DWG. NO.	11,220

THE PRINT MACHINE, INC. N37703

3.00 8 11801