MICROFILMED

FILED
GREENVILLE CO. S.C.
JUN 12 10 49 AM '84
DONNIE S. TANKERSLEY
R.M.C.

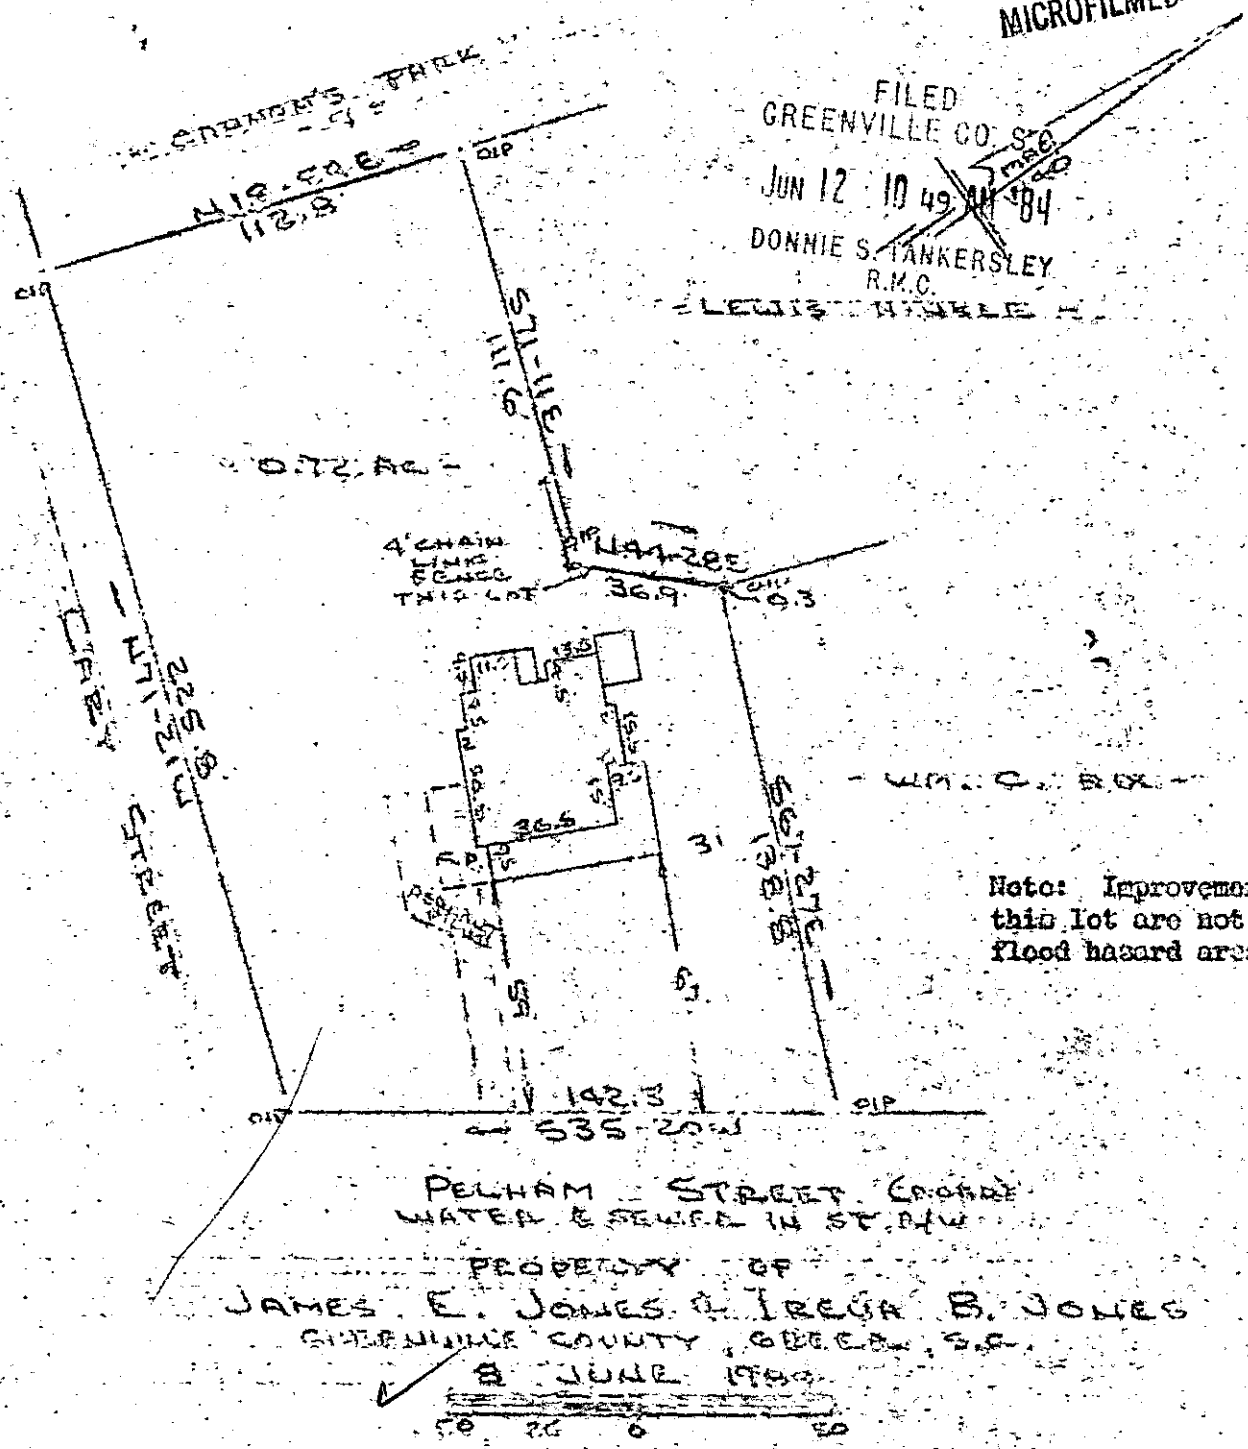

Note: Improvements on this lot are not in a flood hazard area.

This is to certify that on the 8th day of June, 1984, I surveyed the property shown on this plat, being known as 0.72 acre on plat of PROPERTY OF JAMES E. JONES & IREVA B. JONES and recorded in the RMC Office Greenville County, S. C., in Plat Book at Page ; and that the property lines, walls and buildings are as shown hereon, and that the walls and buildings located on said lot do not encroach or project on adjacent street or property, and that no adjacent walls or buildings encroach or project on said premises, and no power lines cross this property except as shown hereon.

39240

JUN 12 1984

10R-91

R. B. Bruce, RLS # 1952

CAROLINA SURVEYING CO.
112 Manly St.
Greenville, S. C.

Recordable Plat

300 8 11801