

FILED
GREENVILLE CO. S.C.

JUN 18 2 37 PM 1984 56-21-59 W 105.93

DONNIE S. TANKERSLEY
R.H.C.




236

238

237

239

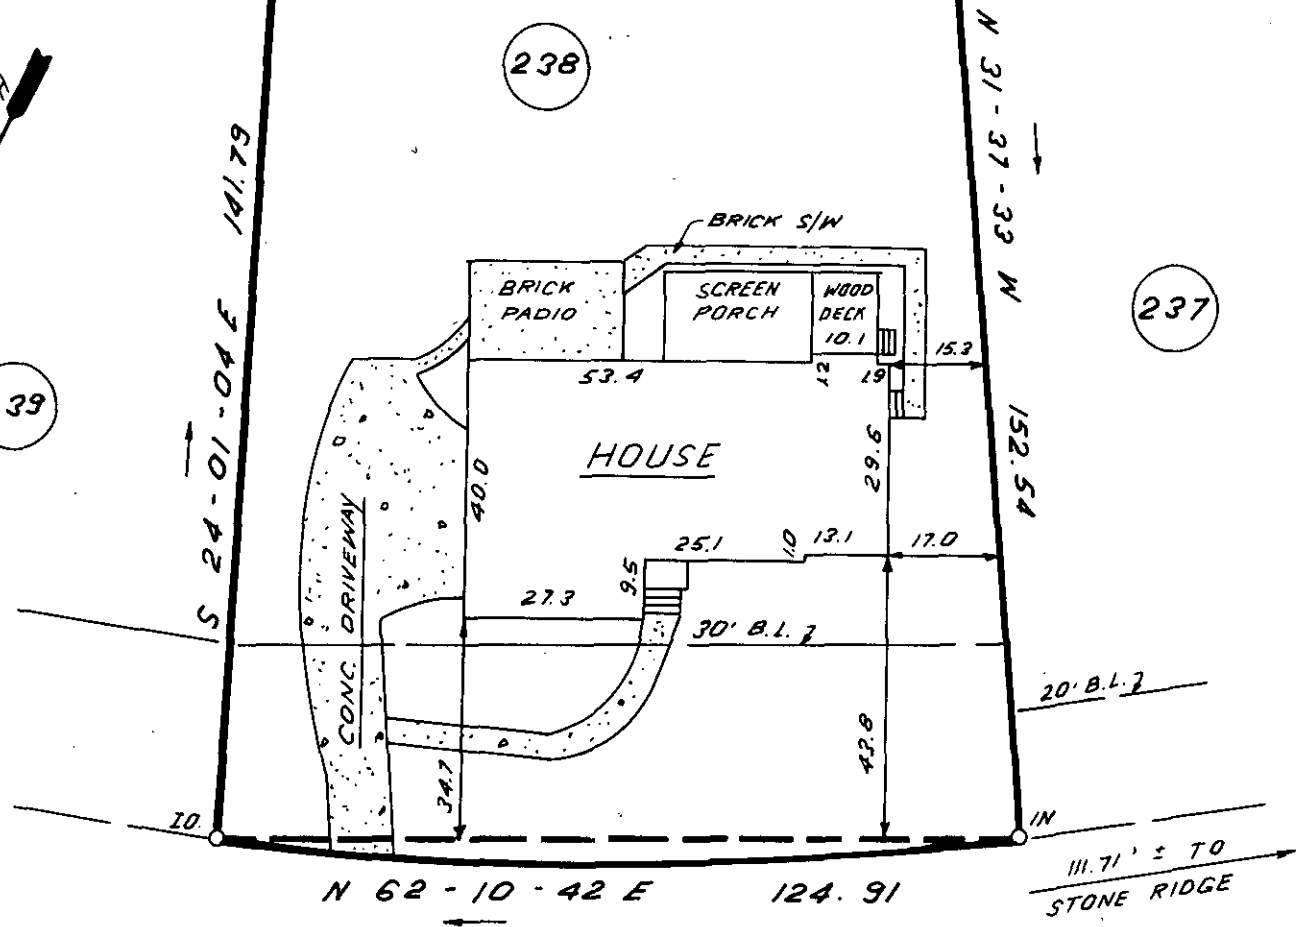

N 62 - 10 - 42 E 124.91

MIDDLE BROOK ROAD

39896

JUN 18 1984

10-5-10



THIS IS TO CERTIFY THAT THE PROPERTY SHOWN ON THIS PLAT WAS SURVEYED UNDER MY DIRECT SUPERVISION. PROPERTY LINES AND IMPROVEMENTS SHOWN ARE LOCATED CORRECTLY AND THAT NO VISIBLE ENCROACHMENTS EXIST UNLESS OTHERWISE SHOWN. THIS PROPERTY IS NOT LOCATED IN A DESIGNATED FLOOD HAZARD AREA.



STATE OF SOUTH CAROLINA
GREENVILLE COUNTY

FREELAND & ASSOCIATES
Engineers • Land Surveyors
318 WEST STONE AVENUE.
GREENVILLE, S.C.
(803) 271-4924

SUGAR CREEK
MAP NO. 4; SEC. 1; LOT 238
PROPERTY OF
THOMAS F. GILMORE
KERRY L. GILMORE

PLAT BOOK	50 - 72
DEED BOOK	
TAX MAP	534.3 - 1 - 230
PARTY CHIEF	RJ
DRAWN	B.R.
DATE	5-17-84
DWG. NO.	11099

RLS. JAMES R. FREELAND
NO: 4781