

SUNBELT PROPERTY

N 22-00 W


PROPERTY LINE

N 58-29 W 73.5

25' SAN. SEWER EASEMENT

N 21-59 W 26.0

(27.62) IN STORAGE

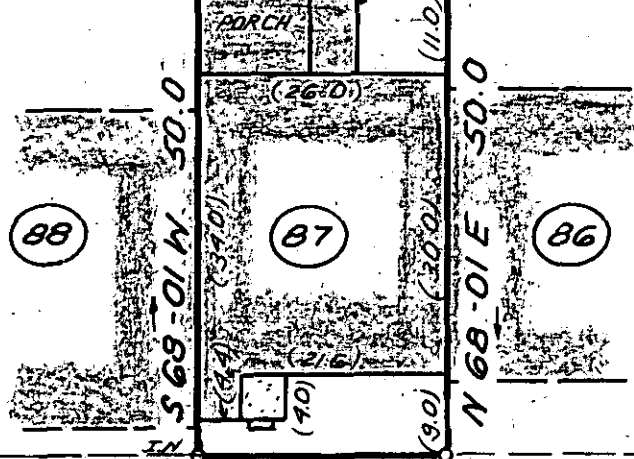

S 21-59 E 26.0

FILED
GREENVILLE CO. S.C.
JUN 18 9 11 AM '84
DONNIE S. JANKERSTLEY
R.M.C.

39892

10-8-14




THIS IS TO CERTIFY THAT THE PROPERTY SHOWN ON THIS PLAT WAS SURVEYED UNDER MY DIRECT SUPERVISION. PROPERTY LINES AND IMPROVEMENTS SHOWN ARE LOCATED CORRECTLY AND THAT NO VISIBLE ENCROACHMENTS EXIST UNLESS OTHERWISE SHOWN. THIS PROPERTY IS NOT LOCATED IN A DESIGNATED FLOOD HAZARD AREA.

STATE OF SOUTH CAROLINA
GREENVILLE COUNTY

FREELAND & ASSOCIATES
Engineers • Land Surveyors
318 WEST STONE AVENUE.
GREENVILLE, S.C.
(803) 271-4924

JAMESTOWNE II
UNIT 87
PROPERTY OF
CHIEN-YEH HSU
PEN-HSIN HSU

PLAT BOOK	9W-33
DEED BOOK	
TAX MAP	
PARTY CHIEF	B.G.
DRAWN	K.E.G.
DATE	6-15-84
DWG. NO.	11291

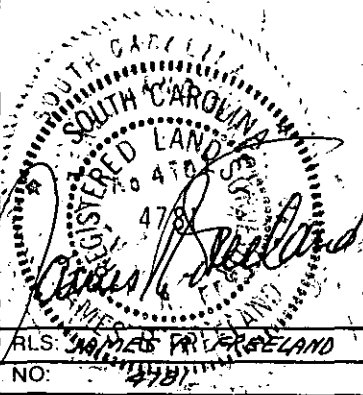

2 UN18 84 1473 3.00CI