


MICROFILMED

Note:
Improvements on this
lot are not in a
flood hazard area.

BERLEY AVENUE

DARLINGTON AVENUE
WATER & SEWER IN ST RIM

PROPERTY OF
DENNIS W. ERSKINE & JARLET R. ERSKINE
NEAR GREENVILLE, S.C.
14 JUNE 1984

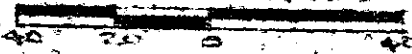

This is to certify that on the 14th day of June, 1984, I surveyed the property shown on this plat, being known as lot 7 on plat of PROPERTY OF ETHEL V. PERRY ESTATE and recorded in the R.M. Office Greenville County, S. C., in Plat Book "Q" at Page 26; and that the property lines, walls and buildings are as shown hereon, and that the walls and buildings located on said lot do not encroach or project on adjacent street or property, and that no adjacent walls or buildings encroach or project on said premises, and no power lines cross this property cross this property except as shown hereon.

39897

10-S-15

R. B. Brace, RES 7 1952

CAROLINA SURVEYING CO.
112 Manly St.
Greenville, S. C.

Recordable Plat

FILED
GREENVILLE CO. S.C.
JUN 18 4 03 PM '84
DONNIE S. JANKERSLEY
R.M.C.

SC712 -- JUN 18 84 1484 3.0001