

MAG 1966

GREENWOOD DRIVE

SS-14E
230'

SS-14W
283'

38E-81S

SS-37E
242.5'

FILED
GREENVILLE CO. S.C.
JUN 21 12 33 PM '84
DONNIE S. TANKERSLEY
R.M.C.

Note: Improvements on this lot are not in a flood hazard area.

1ST DRAINAGE EASEMENT

SEPTIC TANK ON LOT


3.56 AC ±

172E-121N

40335

10. S. 26

PROPERTY OF
STEVEN RAY ELLIOTT, SR. & JUDY L. ELLIOTT
NEAR GREENVILLE, GREENVILLE COUNTY, S.C.
SCALE: 1"=100' 19 JUNE 1984

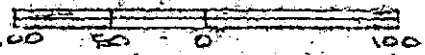

This is to certify that on the 19th day of June, 1984, I surveyed the property shown on this plat, being known as lot 11 (3.56 acres) on plat of REVISION OF MORROW ESTATES and recorded in the REC Office Greenville County, S. C., in Plat Book "TTT" at Page 29 and also known as PROPERTY OF STEVEN RAY ELLIOTT, SR. & JUDY L. ELLIOTT and recorded in the REC Office Greenville County, S. C., in Plat Book at Page ; and that the property lines, walls and buildings are as shown hereon, and that the walls and buildings located on said lot do not encroach or project on adjacent street or property, and that no adjacent walls or buildings encroach or project on said premises, and no power lines cross this property except as shown hereon.

Recordable Plat

CAROLINA SURVEYING CO.
112 Manly St.
Greenville, S. C.

SOUTH CAROLINA REGISTRY
R. B. Bruce
R. B. Bruce, RLS # 1952

2 JUN 21 84 210

3.00