


FILED
GREENVILLE CO. S.C.
JUN 27 11 57 AM '84
DONNIE S. TANKERSLEY
R.M.C.

PECAN DRIVE

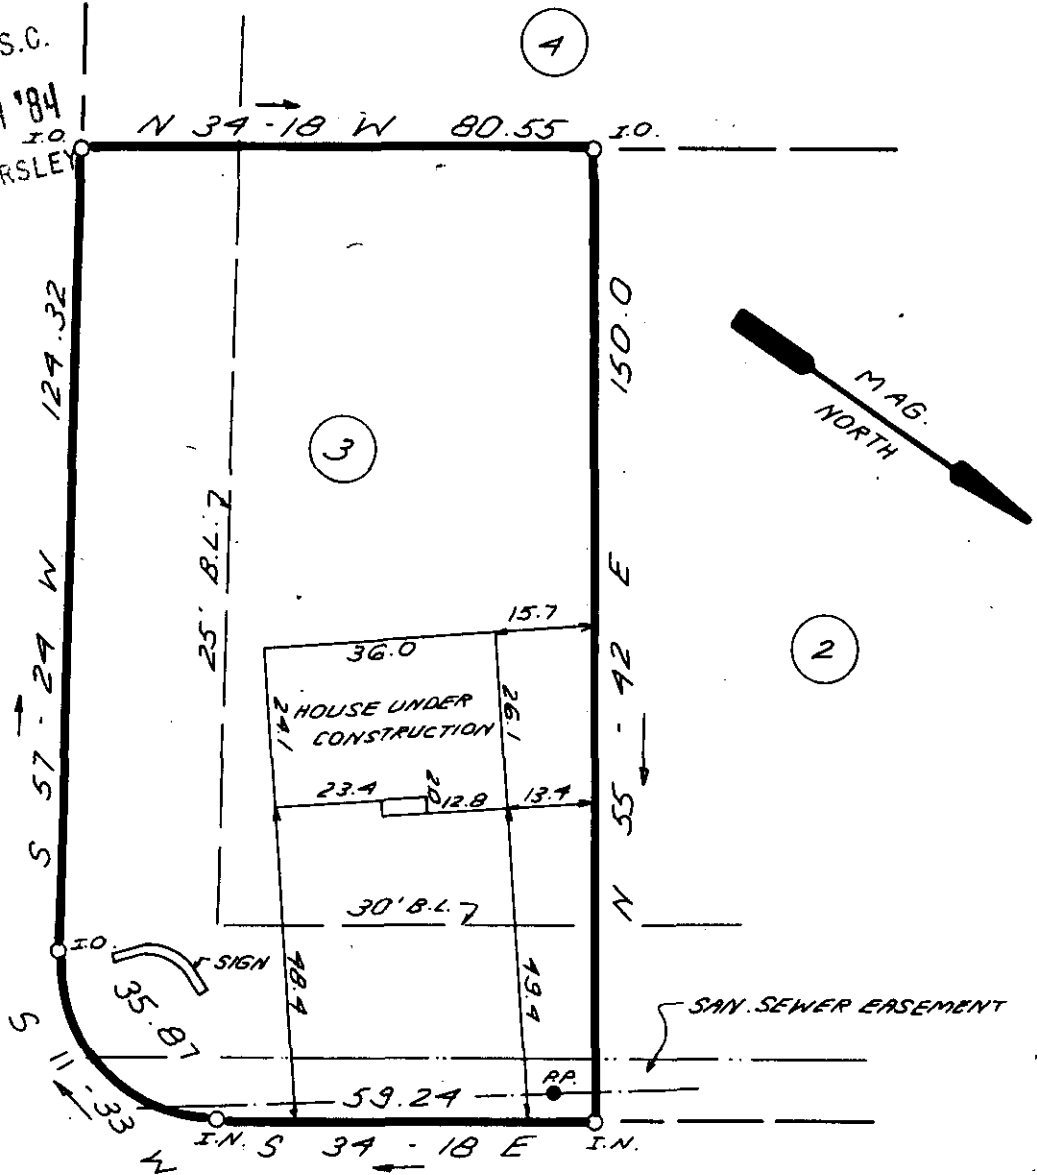

NOTE: 5' DRAINAGE & UTILITY EASEMENT ALONG EACH SIDE OF ALL SIDE & REAR LOT LINES.

HOLLAND ROAD

41000 ✓

JUN 27 1984

105-49



THIS IS TO CERTIFY THAT THE PROPERTY SHOWN ON THIS PLAT WAS SURVEYED UNDER MY DIRECT SUPERVISION. PROPERTY LINES AND IMPROVEMENTS SHOWN ARE LOCATED CORRECTLY AND THAT NO VISIBLE ENCROACHMENTS EXIST UNLESS OTHERWISE SHOWN. THIS PROPERTY IS NOT LOCATED IN A DESIGNATED FLOOD HAZARD AREA.



RLS: JAMES R. FREELAND
NO: 4781

STATE OF SOUTH CAROLINA
GREENVILLE COUNTY

GILDER CREEK ESTATES
PHASE 1 ; LOT 3
PROPERTY OF
DAVID L. WHITLOCK
LISA L. WHITLOCK

FREELAND & ASSOCIATES
Engineers • Land Surveyors
318 WEST STONE AVENUE.
GREENVILLE, S.C.
(803) 271-4924

PLAT BOOK	3W-68
DEED BOOK	
TAX MAP	
PARTY CHIEF	J. R. F.
DRAWN	K. E. G.
DATE	3-13-84
DWG. NO.	10,689