

15 16 17

N 33 - 20 W 95.00

GREENVILLE CO. S.C.
JUN 29 2 20 PM '84
DONNIE S. TANKERSLEY
R.M.C.

15' DRAINAGE EASEMENT

139.89

S 57 - 24 W


139.89

N 57 - 24 E



21

20

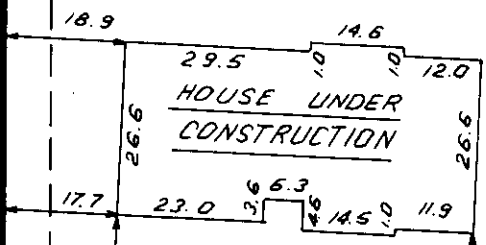

30' B.L.

SAN. SEWER EASEMENT

S 33 - 20 E 95.00

200.44' ± TO PECAN DRIVE

HOLLAND ROAD

41302

JUN 29 1984

10-5-60



NOTE: 5' DRAINAGE & UTILITY EASEMENT ALONG EACH SIDE OF ALL SIDE & REAR LOT LINES.

THIS IS TO CERTIFY THAT THE PROPERTY SHOWN ON THIS PLAT WAS SURVEYED UNDER MY DIRECT SUPERVISION PROPERTY LINES AND IMPROVEMENTS SHOWN ARE LOCATED CORRECTLY AND THAT NO VISIBLE ENCROACHMENTS EXIST UNLESS OTHERWISE SHOWN. THIS PROPERTY IS NOT LOCATED IN A DESIGNATED FLOOD HAZARD AREA



STATE OF SOUTH CAROLINA
GREENVILLE COUNTY

FREELAND & ASSOCIATES
Engineers • Land Surveyors
318 WEST STONE AVENUE.
GREENVILLE, S.C.
(803) 271-4924

GILDER CREEK ESTATES
PHASE 1; LOT 21
PROPERTY OF
JIMMY SKELTON

PLAT BOOK	9W - 68
DEED BOOK	
TAX MAP	
PARTY CHIEF	B.G.
DRAWN	I.R.
DATE	6-26-84
DWG. NO	11368

RLS MACK L. CHAPMAN JR
NO: 10034

1272