

MAG.

FILED GREENVILLE CO., S.C.
 JUL 3 11 19 AM 1984
 DONNIE S. TANKERSLEY
 R.M.C.

T8-4-38
 OUT OF T8-4-38


JUL 3 1984

This is to certify that on May 4, 1983, I surveyed the property shown on this plat, known as Pt. Lot 23 on plat of Columbia Investment Co., recorded in the RMC Office of Greenville County in Plat Book KKK on page 73, also known as a portion of Jay Aaron Stubblefield Property, recorded in Plat Book 70 on page 62, and that the property lines, walls and buildings are as shown hereon; that the building located on said lot does not encroach or project on adjacent streets or property, and that no adjacent walls or buildings encroach or project on said premises, and that no utility lines cross this property except as shown hereon. This property is not located in a designated flood hazard area.

James R. Freeland
 James R. Freeland RLS & PE 4781

10-5-83

391

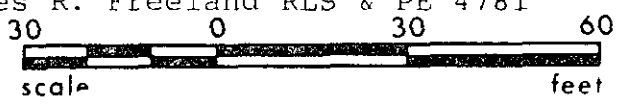

STATE OF SOUTH CAROLINA
 GREENVILLE COUNTY

COLUMBIA INVESTMENT CO.

PT. LOT 23
SURVEY FOR

JERRY N. MARSH

FREELAND & ASSOCIATES
 Engineers • Land Surveyors

GREENVILLE, S.C.

SURVEY	MCC
DRAWN	BR
CHECK	MCC
SCALE	1" = 30'
DATE	MAY 4, 1983
DWG. NO.	8882 - B

PRINT MACHINE INC. 2.0001