MICROFILMED

FILED
GREENVILLE CO. S.C.
JUL 5 1 17 PM '84
DONNIE S. TANKERSLEY
R.M.C.

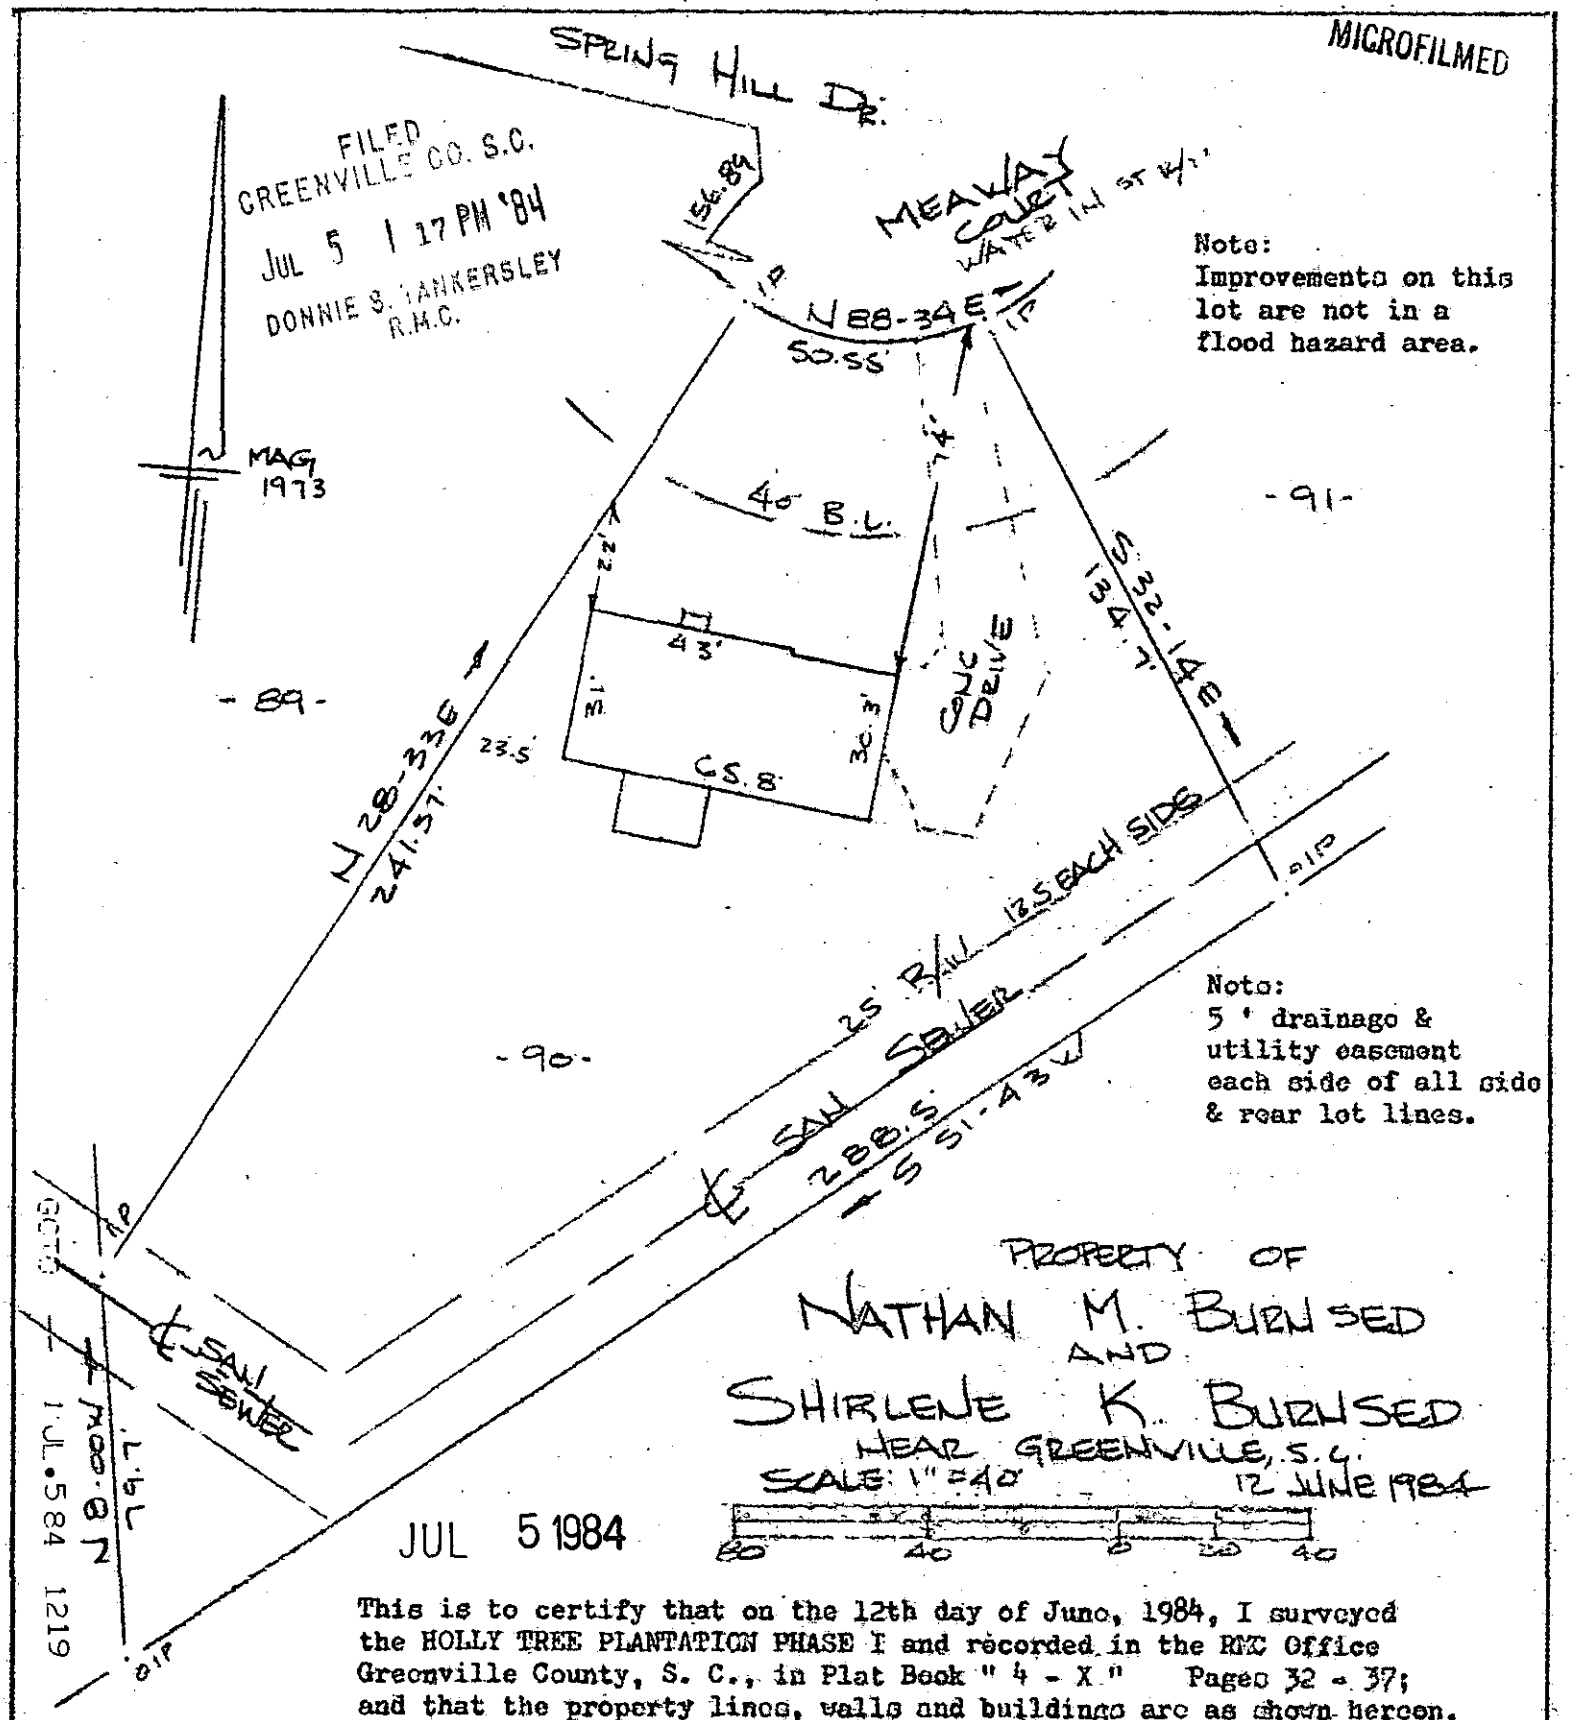

Note:
Improvements on this lot are not in a flood hazard area.

Note:
5 ' drainage & utility easement each side of all side & rear lot lines.

PROPERTY OF
NATHAN M. BURNSED
AND
SHIRLENE K. BURNSED
NEAR GREENVILLE, S.C.
SCALE: 1" = 40'
12 JUNE 1984

JUL 5 1984

This is to certify that on the 12th day of June, 1984, I surveyed the HOLLY TREE PLANTATION PHASE I and recorded in the RMC Office Greenville County, S. C., in Plat Book " 4 - X " Pages 32 - 37; and that the property lines, walls and buildings are as shown hereon, and that the walls and buildings located on said lot do not encroach or project on adjacent street or property, and that no adjacent walls or buildings encroach or project on said premises, and no power lines cross this property except as shown hereon. Also known as PROPERTY OF NATHAN M. BURNSED & SHIRLENE K. BURNSED and recorded in Plat Book at Page

549

10-5-86

R. B. Bruce PLS # 1952

CAROLINA SURVEYING CO.
112 Manly St.
Greenville, S. C.

Recordable Plat

GCTB
JUL 584 1219

3.00CI