



MICROFILMED

FILED
GREENVILLE CO.
AUG 1 11 19 AM '84
DONNIE S. TARKERSLEY
R.M.C.

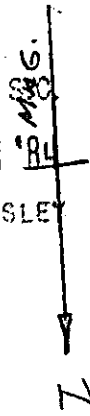

(10)
LOT # 7

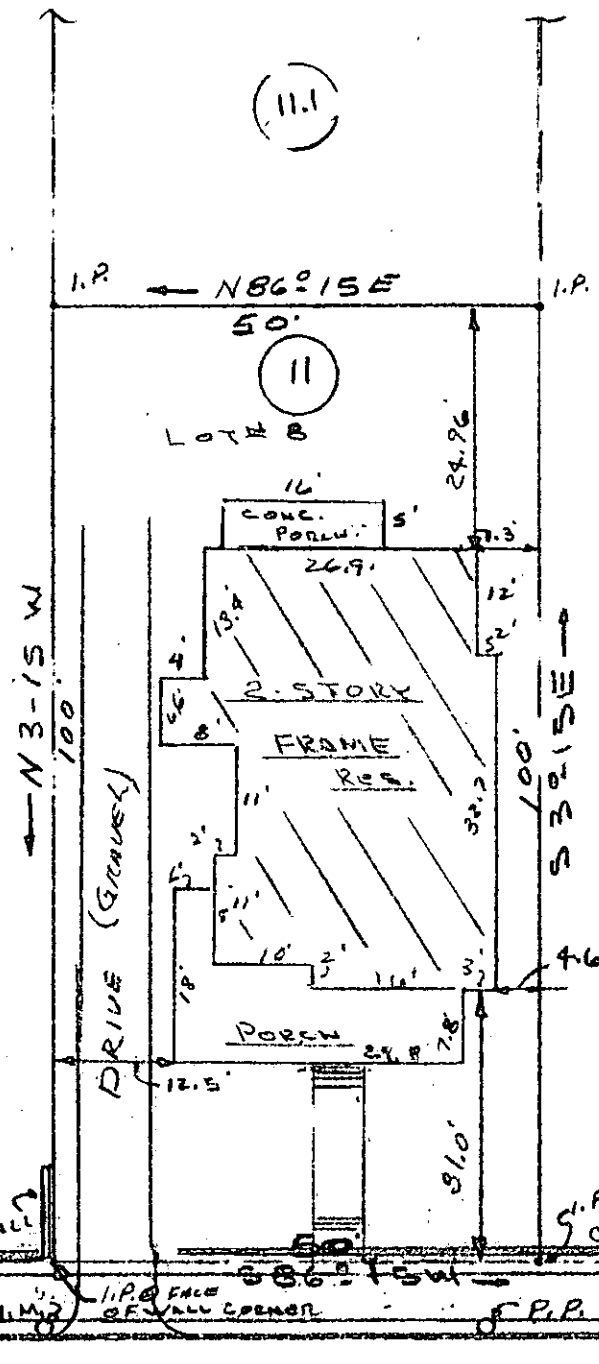

(12)
LOT # 9

BURNS STREET

REF:
BLK. BK. 54. 95-9-11
PLAT BK. 2-200
DEED BK. 1211-501

GREENVILLE CO.
CITY OF GREENVILLE

I CERTIFY THE ABOVE
LOT HAS BEEN SURVEYED
AND HOUSE ETC. LOCATIONS
AS SHOWN TO THE BEST
OF MY KNOWLEDGE. NO
ENCROACHMENTS AND NOT
LOCATED IN AN ARIARIS
FLOOD PLAIN AREA.
SURVEY AS PER PLAT BK. 2-200
1-9-84

AUG 1 1984 3554

✓ 10-4-49

M.H.

← SAN SEWER LINE
← 700± TO AUGUSTA ST.

WOODFIN AVE (ASPH)

WATER, SEWER & POWER ALONG STREET.

PROPERTY OF CHARLES B. CAMPBELL		
SCALE: 1"=20'	APPROVED BY	DRAWN BY KTG.
DATE: 5-16-84		
		DRAWING NUMBER