





30

29

28

FILED
GREENVILLE CO. S.C.
JUL 17 9 32 AM '84
DONNIE S. TARKERSLEY
R.M.C.

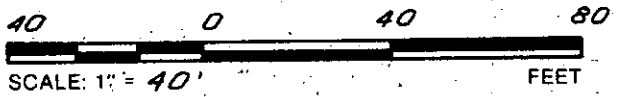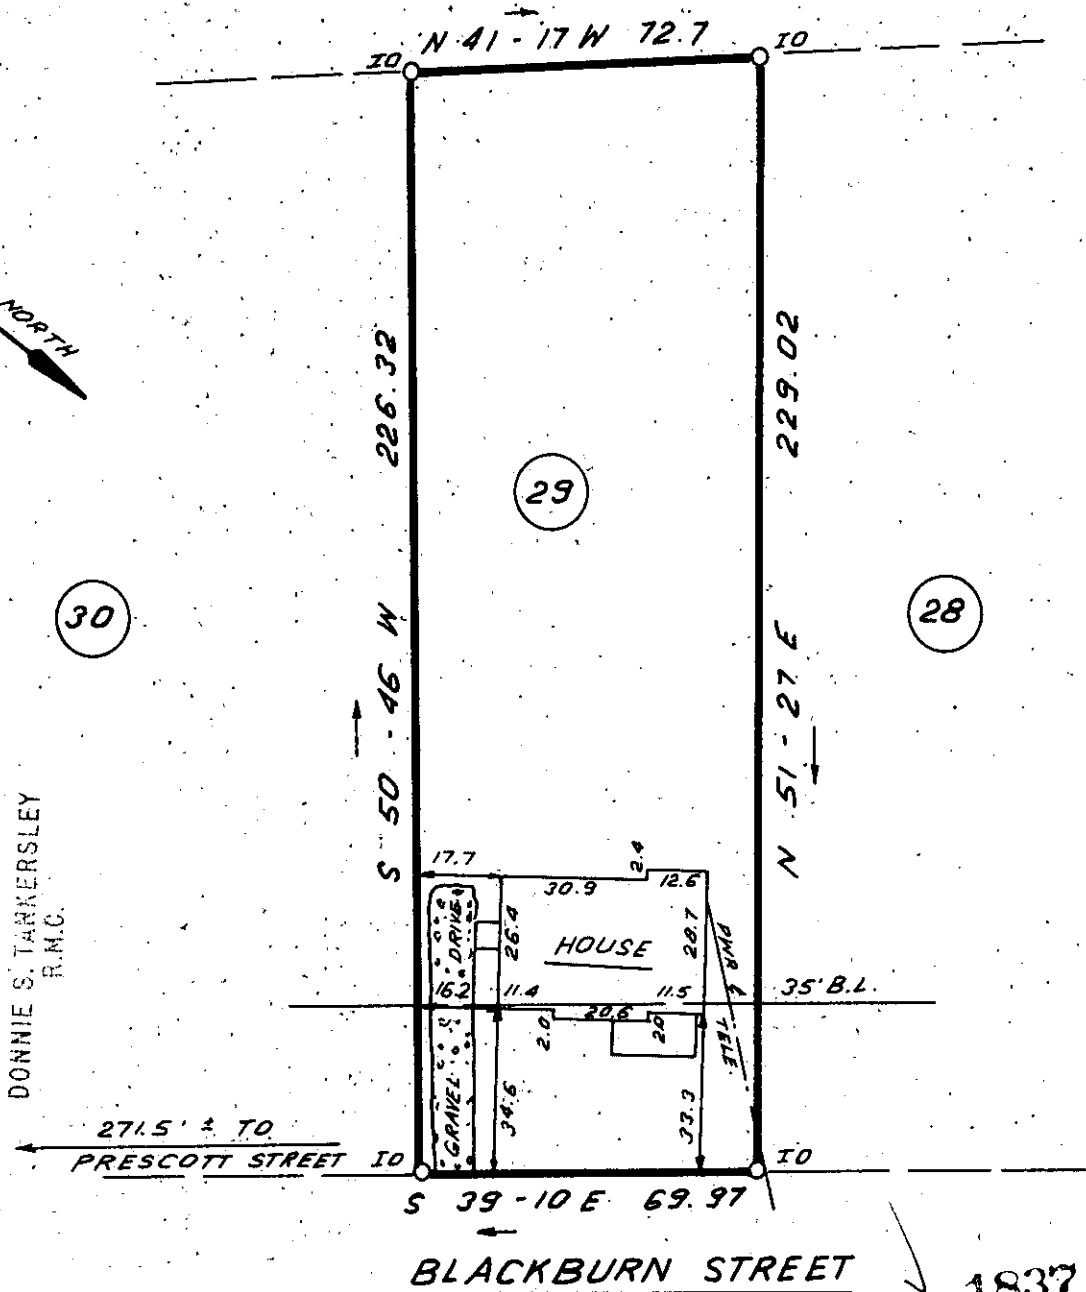

10-V-10

THIS IS TO CERTIFY THAT THE PROPERTY SHOWN ON THIS PLAT WAS SURVEYED UNDER MY DIRECT SUPERVISION. PROPERTY LINES AND IMPROVEMENTS SHOWN ARE LOCATED CORRECTLY AND THAT NO VISIBLE ENCROACHMENTS EXIST UNLESS OTHERWISE SHOWN. THIS PROPERTY IS NOT LOCATED IN A DESIGNATED FLOOD HAZARD AREA.



STATE OF SOUTH CAROLINA
GREENVILLE COUNTY

ISAUQUEENA PARK
LOT 29
PROPERTY OF
JAMES D. MYERS
VICKIE T. MYERS

FREELAND & ASSOCIATES
Engineers • Land Surveyors
318 WEST STONE AVENUE.
GREENVILLE, S.C.
(803) 271-4924

| | |
|-------------|------------|
| PLAT BOOK | P-130 |
| DEED BOOK | 695-161 |
| TAX MAP | 189-3-4-16 |
| PARTY CHIEF | J.C. |
| DRAWN | I.R. |
| DATE | 7-3-84 |
| DWG. NO. | 11424 |

2 JUL 17 84 1107 3.00CI