


MICROFILMED

FILED
GREENVILLE CO. S.C.
JUL 18 11:41 AM '84
DONNIE S. WALKERSLEY
R.M.C.

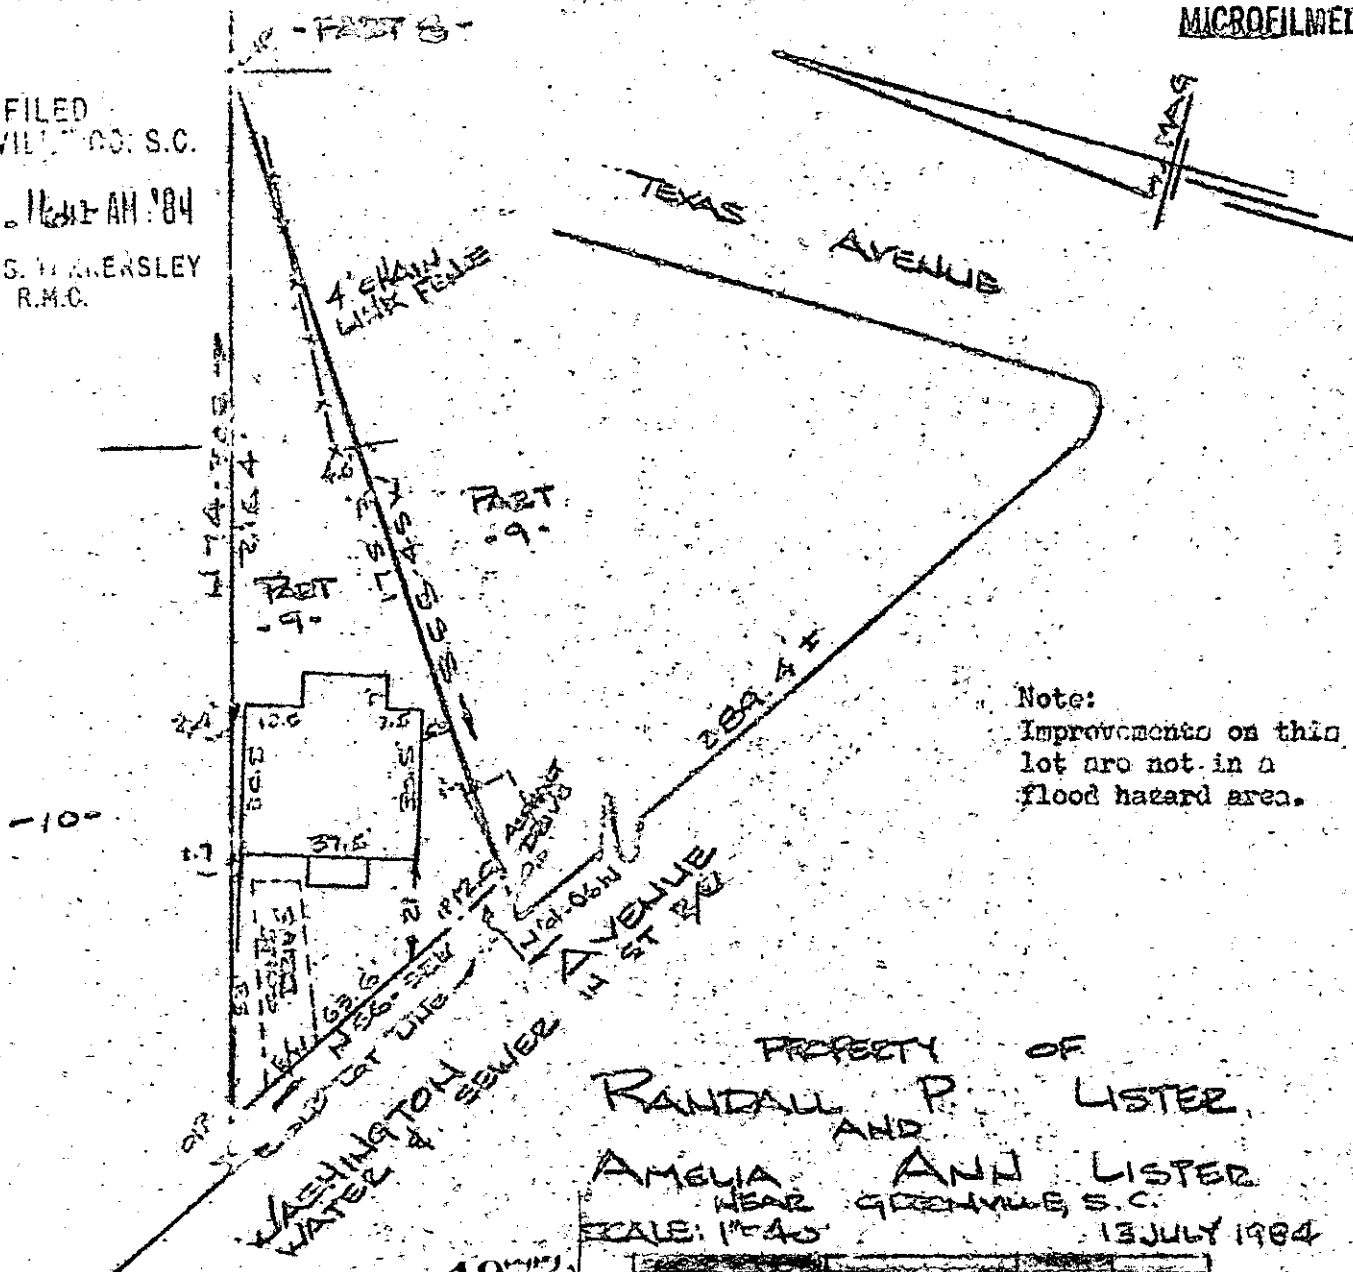

Note:
Improvements on this
lot are not in a
flood hazard area.

PROPERTY OF
RANDALL P. LISTER
AND
AMELIA ANN LISTER
NEAR GREENVILLE, S.C.

SCALE: 1"=40'
13 JULY 1984

1977
JUL 18 1984

10-V-12

This is to certify that on the 13th day of July, 1984, I surveyed the property shown on this plat, being known as part of Lot 9 on plat of HIGHLAND SUBDIVISION and recorded in the REC Office Greenville County, S. C., in Plat Book "K" at Pages 50 & 51 and also being known as PROPERTY OF RANDALL P. LISTER & AMELIA ANN LISTER and recorded in Plat Book _____ at Page _____; and that the property lines, walls and buildings are as shown hereon, and that the walls and buildings located on said lot do not encroach or project on adjacent street or property, and that no adjacent walls or buildings encroach or project on this property, and no power lines cross this property except as shown hereon.

R. B. [Signature]
R. B. [Signature] BLS # 1972

CAROLINA SURVEYING
117 [unclear] St.
Greenville, S.C.

Recordable Plat

100
1801