



FILED
GREENVILLE CO. S.C.
JUL 27 9 44 AM '84
DONNIE S. WALKERSLEY
R.M.C.
MAG. NORTH

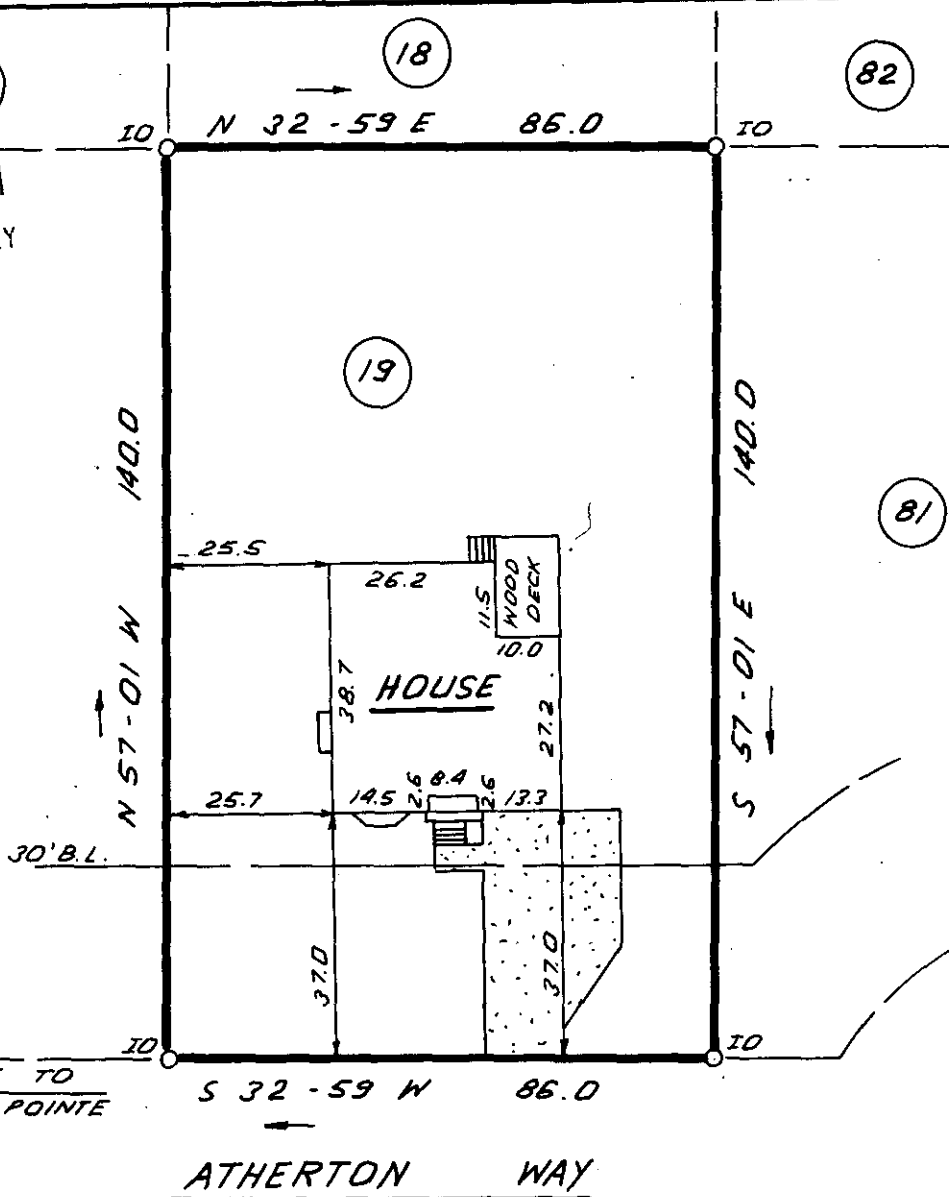


JUL 27 1984

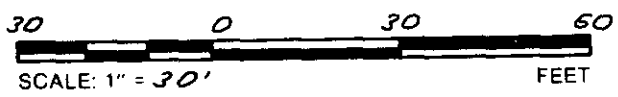

10-V-47 2974 ✓

THIS IS TO CERTIFY THAT THE PROPERTY SHOWN ON THIS PLAT WAS SURVEYED UNDER MY DIRECT SUPERVISION. PROPERTY LINES AND IMPROVEMENTS SHOWN ARE LOCATED CORRECTLY AND THAT NO VISIBLE ENCROACHMENTS EXIST UNLESS OTHERWISE SHOWN. THIS PROPERTY IS NOT LOCATED IN A DESIGNATED FLOOD HAZARD AREA.

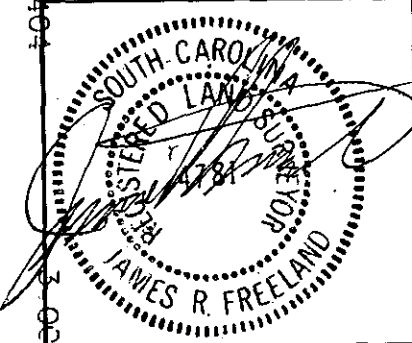

**STATE OF SOUTH CAROLINA
GREENVILLE COUNTY**

FREELAND & ASSOCIATES
Engineers • Land Surveyors
318 WEST STONE AVENUE.
GREENVILLE, S.C.
(803) 271-4924

DEVENGER POINTE
SEC. 1; LOT 19
PROPERTY OF
TREVOR A. LYNFATT
GRACE W. LYNFATT

PLAT BOOK	9F - 59
DEED BOOK	1206 - 723
TAX MAP	540-24-1-17
PARTY CHIEF	L. T.
DRAWN	I. R.
DATE	7-16-84
DWG. NO.	11480

PLS: JAMES R. FREELAND
NO: 4781