MICROFILMED

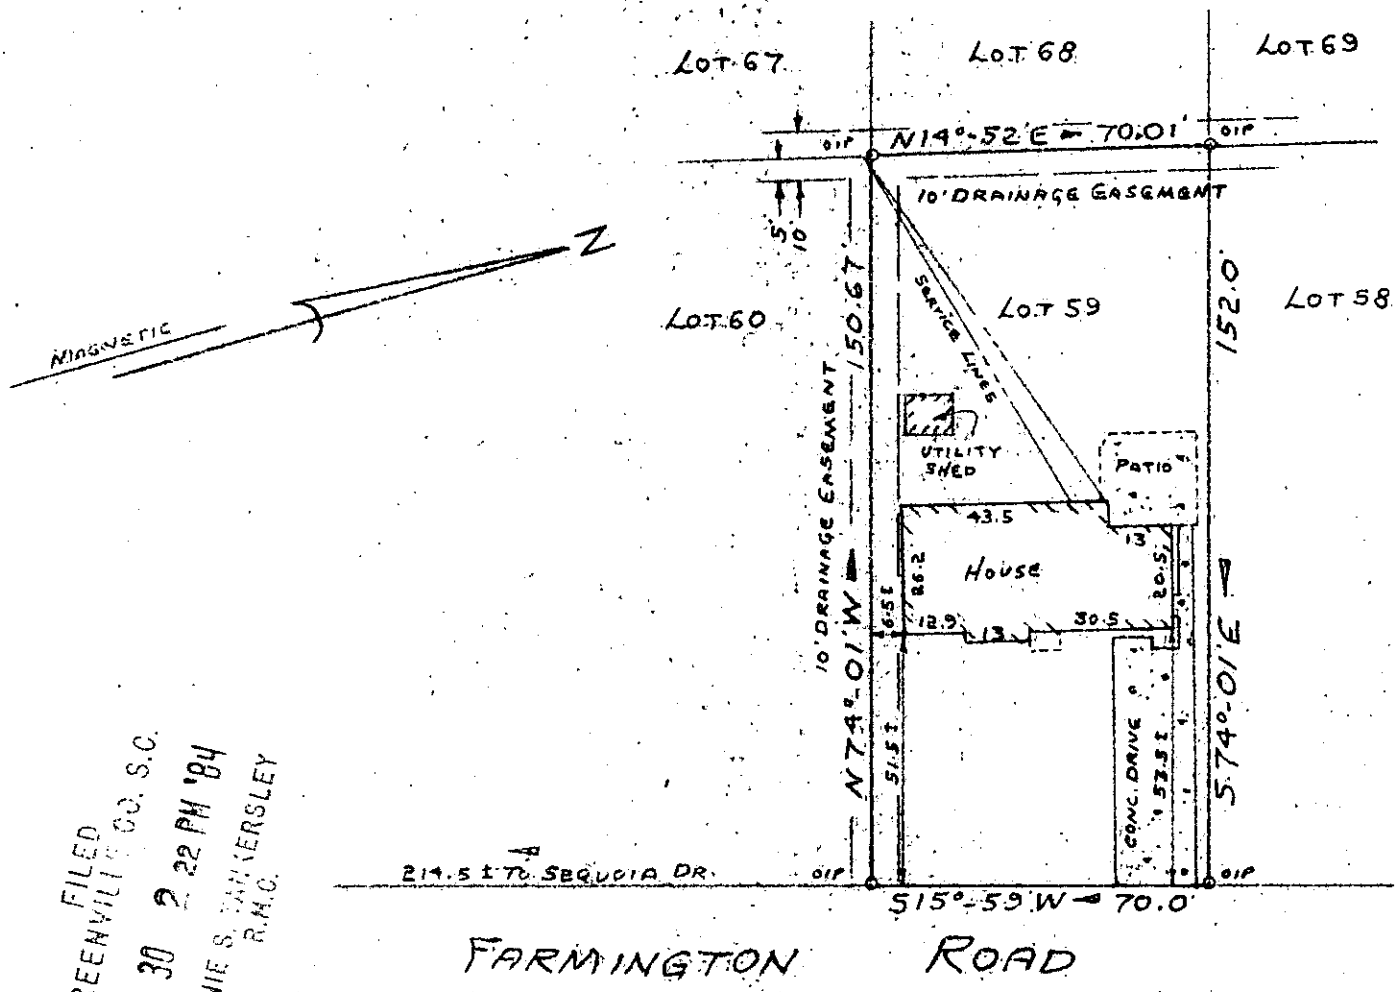

FILED
GREENVILLE CO. S.C.
JUL 30 2 22 PM '84
DONNIE S. TANKERSLEY
R.M.C.

PROPERTY OF

L. ANDREW MARSHBANKS

AND

JEANNETTE S. MARSHBANKS

JUL 30 1984

GREENVILLE, GREENVILLE COUNTY, SOUTH CAROLINA

JULY 27, 1984 SCALE 1"=40'

3212 10-V-52

This is to certify that on July 27, 1984, I surveyed the property shown on this plat known as Lot No. 59 of Chestnut Hills as recorded in the RMC Office for Greenville County in Plat Book GG at Pages 34 and 35, and that the property lines, walls and buildings are as shown hereon, and that the building located on said lot does not project nor encroach on adjacent streets or property, and that no adjacent walls or buildings project nor encroach on said lot, and that no utility lines cross this lot except as may be shown hereon. The degree of accuracy is 1/10,000.

NOTE: This property is not located within a flood hazard area.

Surveyed by: Richard D. Wooten, Jr.
Greenville, South Carolina

S. C. R. L. S. no. 4678

Dwg. No. 3514