

MICROFILMED

16 PAGE

523-132

FILED

GREENVILLE CO. S.C.

71-75

0.00

JUL 30 4 02 PM '84


DONALD S. WALKERSLEY  
100 E. 12th ST.  
R.H.C.  
FIRE ALARM CO.

STREET

100-7500

0

10575

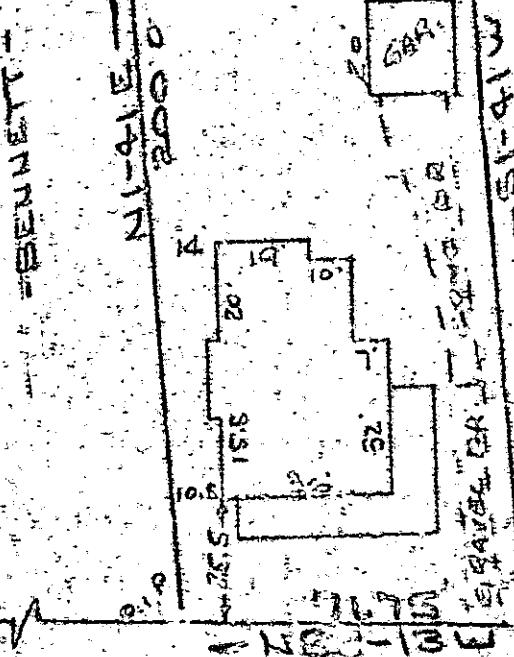

- NEC-13W

5145

WEST EARL STREET  
WATKINS & SAWYER INC. SURVEY  
PROPERTY OF

L. KENNETH DORITY JR. & KATHRYN C. DORITY  
GREENVILLE, S.C.  
RECEIVED JUL 26 1984 26 JULY 1984

-2 JU 30 84

5566

I, L. KENNETH DORITY JR., of Greenville, S.C., being sworn to, do hereby state, that I am the owner of the property described on this plat, being located in the CITY OF GREENVILLE, SOUTH CAROLINA. I have duly recorded the same in the office of the Register of Deeds, S.C., in Plat Book "9-V" at Page 31, and that the property is free, clear and unencumbered as shown herein, and that no partition and boundary line stated on said lot do not encroach or extend on claim of right or priority, and that no adjacent lands or buildings, or other property, which are or may be situated, and or front thereon across this property, do not in any way encroach or interfere therewith.

10-V-55

3260

R. B. PARCELLS

Recordable Plat

100CC

746175

5-1-16